

SURVEY & REMONUMENTATION

1993

COMMISSION

For corners in

BARRY

(County)

BARRY COUNTY REMONUMENTATION LAND CORNER RECORDATION CERTIFICATE
Filing Requirement of Act 74, Mich. P.A. 1970

STATE OF MICHIGAN
COUNTY OF BARRY
RECEIVED FOR RECORD

JUL 20 11 20 AM '93

Sandy Schondelmarper
REGISTER OF DEEDS

002046

Register of Deeds Stamp & File Number

- | | | |
|------------------------------------|-------------------------|-------------------------|
| 1. Public Land Survey | T <u>3N</u> R <u>8W</u> | <u>J-11</u> |
| | T _____ R _____ | <u>HASTINGS TWNSP.</u> |
| | T _____ R _____ | <u>(1/4 COR. 26-35)</u> |
| | T _____ R _____ | _____ |
| 2. Property Controlling in Section | S _____ T _____ R _____ | _____ |
| | S _____ T _____ R _____ | _____ |
| 3. Miscellaneous Property in Sec. | S _____ T _____ R _____ | _____ |
| | S _____ T _____ R _____ | _____ |
4. Lot No. _____, Recorded Plat _____
5. Private Claims _____

A	B	C	D	E	F	G	H	I	J	K	L
2	6	5	4	3	2	1					
3											
4	7	8	9	10	11	12					
5											
6	13	17	16	15	14	13					
7											
8	19	20	21	22	23	24					
9											
10	30	29	28	27	26	25					
11											
12	31	32	33	34	35	36					
13											

BRIAN REYNOLDS

JAN

93

I, _____, in a field survey on _____, 19 _____, do hereby certify that under requirements of P.A. 74, Michigan P.A. of 1970, the corner points mentioned in lines 1 and 2 above were in conformance with regulations and rules therefore as required in the current manual of survey instructions of the United States Department of the Interior, Bureau of Land Management or by a decree of a Court of Law and/or that the corner points mentioned in lines 3, 4 and 5 above were in conformance with the rules of the Michigan Board of Land Surveyors or by a Decree of a Court of Law; established, re-established, monumented, re-monumented, recovered, found as expressed below:


NOTE: Not more than 4 corners, all in the same town and range, may be recorded on this certificate.

A. Description of original monument and accessories and/or subsequent restoration:

G.L.O. :	Road Comm. (no date)	Highway Constr. Plans (no date)	M.S.H.D. (1961)
Set post	3/8" Steel Pin	.82' Lt. of Sta. 142+88.85	U.P. N72E 87.34'
An Elm 7 N 34	T.P. N72E 87.34'	3/8" Steel Pin	U.P. S50W 45.85'
Tammerack 10 S13W 69	P.P. S50W 45.85'	Witnesses same as Road Comm.	U.P. N51W 44.98'
	T.P. N51W 44.98'		Boat Spike S2E 150.12'
			Boat spike S2E 201.42'

B. Description of corner evidence found and/or method applied in restoring or reestablishing corner:

Found iron rod in monument box.
Fits Highway Construction Stationing. All previous witnesses gone.

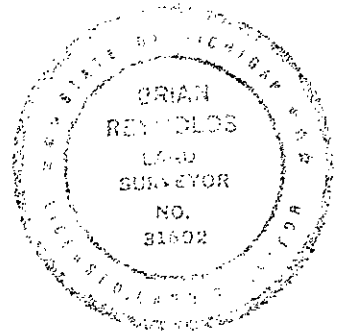

C. Description of monument for corner and accessories established to perpetuate locating the position of the corner:

- SET 3/4" IRON PIN, W/ALUM. REMON. CAP & PUNCH HOLE
- 1/2" IRON W/ORANGE CAP (REYNOLD'S TRAV. POINT) N45W 20.00'
- " " " " " N45E 20.00'
- " " " " " S45E 20.00'
- " " " " " S45W 20.00'
- 40 D NAIL W/BARRY Co. SHINER NW. FACE 14" BOX ELDER S18E 73.76'
- " " " " " NW. FACE 10" POPLAR S57E 107.47'
- +/- 1' N. PAINTED C/L M-79

Signed by *Brian Reynolds* Date 7-13-1993

Surveyor's Michigan License No. 31602