

SURVEY & REMONUMENTATION

1993

COMMISSION

BARRY COUNTY REMONUMENTATION

LAND CORNER RECORDATION CERTIFICATE

Filing Requirement of Act 74, Mich. P.A. 1970

STATE OF MICHIGAN
COUNTY OF BARRY
RECEIVED FOR RECORD

JUL 20 11 20 AM '93

Sandy Schondelmayer
REGISTER OF DEEDS

002050

For corners in BARRY
(County)

Located In: Corner Code #

- | | | | |
|------------------------------------|----|----|-------------------|
| 1. Public Land Survey | 3N | 8W | J-12 |
| | T | R | HASTINGS TOWNSHIP |
| | T | R | CENTER SEC. 35 |
| | T | R | |
| | T | R | |
| 2. Property Controlling in Section | S | T | R |
| | S | T | R |
| 3. Miscellaneous Property in Sec. | S | T | R |
| | S | T | R |
4. Lot No. _____, Recorded Plat _____
5. Private Claims _____

Register of Deeds Stamp & File Number

	A	B	C	D	E	F	G	H	I	J	K	L
2	6		5		4		3		2		1	
3												
4	7		8		9		10		11		12	
5												
6	18		17		16		15		14		13	
7												
8	19		20		21		22		23		24	
9												
10	30		29		28		27		26		25	
11												
12	31		32		33		34		35		36	
13												

BRIAN REYNOLDS MAY 93

I, BRIAN REYNOLDS, in a field survey on MAY 93, 1993, do hereby certify that under requirements of P.A. 74, Michigan P.A. of 1970, the corner points mentioned in lines 1 and 2 above were in conformance with regulations and rules therefore as required in the current manual of survey instructions of the United States Department of the Interior, Bureau of Land Management or by a decree of a Court of Law and/or that the corner points mentioned in lines 3, 4 and 5 above were in conformance with the rules of the Michigan Board of Land Surveyors or by a Decree of a Court of Law; established, re-established, monumented, re-monumented, recovered, found as expressed below:


NOTE: Not more than 4 corners, all in the same town and range, may be recorded on this certificate.

A. Description of original monument and accessories and/or subsequent restoration:

Not set by G.L.O.. No record found in County surveyor's notes. Reynolds (Jan 93)
Set 1/2" iron at intersection of 1/4 lines.
40 d nail - yellow plastic cap - 10" Maple - S45E - 30.54'
" " " " " " " " - S80E - 24.50'
" " " " " " " " - 5" Elm - S - 11.07'

B. Description of corner evidence found and/or method applied in restoring or reestablishing corner:

FOUND "REYNOLDS" CAPPED IRON AND WITNESSES.

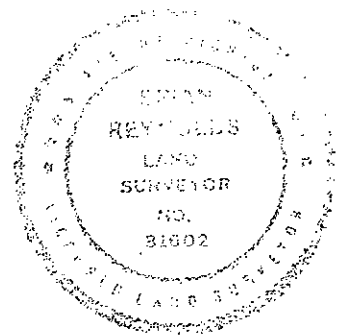

C. Description of monument for corner and accessories established to perpetuate locating the position of the corner:

**REPLACED CAPPED IRON WITH 3/4" IRON PIN, ALUM. REMON. CAP AND PUNCH HOLE:
ALL PREVIOUS WITNESSES PRESENT AND CORRECT.
NEW WITNESSES:
40 D NAIL - BARRY Co. SHINER - 10" MAPLE - S50E - 1.60'
OLD BURRIED FENCE CORNER +/- 17' E.**

Signed by [Signature] Date 7-13-1993
Surveyor's Michigan License No. 31602