SURVEY & REMONUMENTATION

1993

COMMISSION

STATE OF MICHIGAN
COUNTY OF BARRY
RECEIVED FOR RECORD

JUL 20 11 20 AM '93

Sandy Schondelmayer
REGISTER OF DEEDS

BARRY COUNTY REMONUMENTATION

LAND CORNER RECORDATION CERTIFICATE

Filing Requirement of Act 74, Mich. P.A. 1970

002051

Register of Deeds Stamp & File Number

For corners in BARRY (County)

	Located In:	Corner Code ##
1. Public Land Survey	T 3N R 8W	J-13
	T ___ R ___	HASTINGS TWNSP.
	T ___ R ___	(S1/4 COR. SEC. 35)
	T ___ R ___	
2. Property Controlling	S ___ T ___ R ___	
in Section	S ___ T ___ R ___	
3. Miscellaneous	S ___ T ___ R ___	
Property in Sec.	S ___ T ___ R ___	

4. Lot No. _____ , Recorded Plat _____
5. Private Claims _____

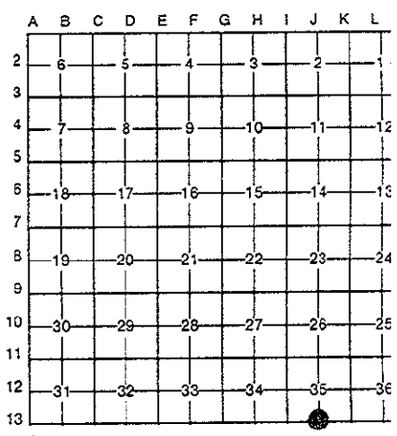

I, BRIAN REYNOLDS, in a field survey on MAY 93, 19 ____, do hereby certify that under requirements of P.A. 74, Michigan P.A. of 1970, the corner points mentioned in lines 1 and 2 above were in conformance with regulations and rules therefore as required in the current manual of survey instructions of the United States Department of the Interior, Bureau of Land Management or by a decree of a Court of Law and/or that the corner points mentioned in lines 3, 4 and 5 above were in conformance with the rules of the Michigan Board of Land Surveyors or by a Decree of a Court of Law; established, re-established, monumented, re-monumented, recovered, found as expressed below:

NOTE: Not more than 4 corners, all in the same town and range, may be recorded on this certificate.

A. Description of original monument and accessories and/or subsequent restoration:

G.L.O. :
Set post
W. Ash 8 N76E 47
Boxwood 6 N29 1/2W 25

B. Description of corner evidence found and/or method applied in restoring or reestablishing corner:

REYNOLDS (JAN 93)

Found 1/2" iron on C-L Sager Rd. E - W..
Fit fence to N.
C-L Bird Rd. +/- 10' E.

FND. 1/2" IRON
W. FACE - 28" OAK - N10W - 26.64'
N. FACE - 15" MAPLE - S65W - 65.19'
N. SIDE - 10" FENCE POST CORNER - S45E - 43.77'
CENTER TOP - TELE. RISER - N45E - 35.88'
(40 D NAIL AND ORANGE (REYNOLDS - TRAV. PT.) CAP FOR WIT.)

C. Description of monument for corner and accessories established to perpetuate locating the position of the corner:

REPLACED 1/2" IRON WITH 3/4" IRON PIN, ALUM. REMON CAP. AND PUNCH HOLE:
ALL PREVIOUS WITNESSES (REYNOLDS - JAN 93) PRESENT AND CORRECT.
28" OAK - N10W - NOW AN OAK STUMP;
TELE. RISER - N45E - HAS #3501
NEW WITNESSES:
40 D NAIL - BARRY Co. SHINER - W. FACE - 30" SHAGBARK HICKORY - N15E - 24.80'
" " S. SIDE - UTIL. POLE # 196/30 - N50W - 81.11'

BRIAN REYNOLDS LAND SURVEYOR NO. 31602 LICENSED LAND SURVEYOR

Signed by _____ Date 7-13-93

Surveyor's Michigan License No. 31602

FORM APPROVED BY MICHIGAN STATE BOARD OF LAND SURVEYORS, JAN. 28, 1
REVISED MAY 14, 1
REVISED JAN., 1