

**SURVEY & REMONUMENTATION**

FEB 17 1998

Barry County Remonumentation

**SECTION**

**LAND CORNER RECORDATION CERTIFICATE**  
Filing Requirement of Act 74, Mich. P.A. 1970

For corners in Barry

(County)	Located In:	Corner Code <del>##</del>
1. Public Land Survey	T 3N R 8W	K-6 (East 1/4 14)
	T _____ R _____	Hastings Twp.
	T _____ R _____	
	T _____ R _____	
2. Property Controlling in Section	S _____ T _____ R _____	
	S _____ T _____ R _____	
3. Miscellaneous Property in Sec.	S _____ T _____ R _____	
	S _____ T _____ R _____	



**2625**  
Page: 1 of 2  
10/20/1997 01:01P

Sandy Schondelmayer - Barry Co. LCRCR

Register of Deeds Stamp & File Number

4. Lot No. \_\_\_\_\_, Recorded Plat \_\_\_\_\_  
5. Private Claims \_\_\_\_\_

A	B	C	D	E	F	G	H	I	J	K	L	M
2	6	5	4	3	2							
3												
4	7	8	9	10	11	12						
5												
6	18	17	16	15	14	13						
7												
8	19	20	21	22	23	24						
9												
10	30	29	28	27	26	25						
11												
12	31	32	33	34	35	36						
13												

Steven Koerber August 31 96

I, \_\_\_\_\_, in a field survey on \_\_\_\_\_, 19\_\_\_\_, do hereby certify that under requirements of P.A. 74, Michigan P.A. of 1970, the corner points mentioned in lines 1 and 2 above were in conformance with regulations and rules therefore as required in the current manual of survey instructions of the United States Department of the Interior, Bureau of Land Management or by a decree of a Court of Law and/or that the corner points mentioned in lines 3, 4 and 5 above were in conformance with the rules of the Michigan Board of Land Surveyors or by a Decree of a Court of Law; established, re-established, monumented, re-monumented, recovered, found as expressed below:

**NOTE: Not more than 4 corners, all in the same town and range, may be recorded on this certificate.**

A. Description of original monument and accessories and/or subsequent restoration:

- |                                      |                      |                                    |
|--------------------------------------|----------------------|------------------------------------|
| K-6 GLO - Sylvester Sibley D.S. 1830 | 1. A.C. Willson 1867 | 2. Bowen Dec 24 1877               |
| A. Sugar 9 S75E 34                   | W.O. 20 S42 1/2W 73  | Found old post & one U.S. bearing. |
| A. B. Ash 10 S89W 41                 | W.O. 20 N81 1/2W 86  | Set stake & Stones                 |
|                                      |                      | Beech 12 East 56                   |

Additional info. on back


B. Description of corner evidence found and/or method applied in restoring or reestablishing corner:

- K-6 Found Railroad Spike as indicated in No. 3 above.  
Found spike in SE side 14" twin Basswood SW 32.10'  
Found spike on North side Wood Fence post East 29.80'  
Accepted the Railroad spike and is accepted as a careful and faithful reestablishment of the position of the corner.

ACT 345 BARRY COUNTY REMONUMENTATION  
APPROVED BY PEER REVIEW AT A MEETING HELD ON  
JULY 8, 1996 BR  
BRIAN REYNOLDS COUNTY SURVEYOR

C. Description of monument for corner and accessories established to perpetuate locating the position of the corner:

- K-6 Set Standard Barry Co. Mon. ( 3/4" x 24" Iron Rod with Aluminum cap) in mon. box.  
Set spike & Barry Co. Remon. tag in N side 6" Hickory N75W 31.03'  
Fnd spike in SE side 14" twin Basswood S70W 32.10'  
Set spike & Barry Co. Remon. tag in N side 8" Ash N65W 45.91'  
Fnd spike in N side Wood fence post East 30.02'

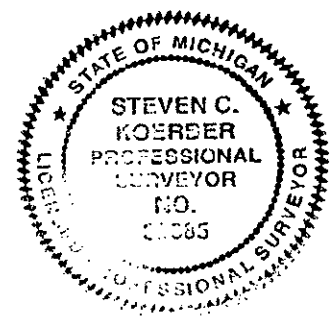


Signed by SK Date 10-13-1997  
Surveyor's Michigan License No. 39085

SURVEY &  
REMONUMENTATION

FEB 17 1998

SECTION

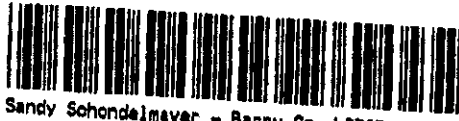

2625

Page: 2 of 2  
10/20/1997 01:01P

Sandy Schondelmayer - Barry Co. LCRCR

Page 2 of 2

3. L.C.R.C. 348  
March 18, 1983  
Carl P. Englert, Jr.

Set R.R. spike on road centerline and fence lines East and West  
Twin Basswood SW 32.10'  
10" Ash NW 42.29'  
8" Elm SSE 99.06'  
Fence post East 29.80'