

SURVEY & REMONUMENTATION

1993

COMMISSION

**BARRY COUNTY REMONUMENTATION
LAND CORNER RECORDATION CERTIFICATE
Filing Requirement of Act 74, Mich. P.A. 1970**

STATE OF MICHIGAN
COUNTY OF BARRY
RECEIVED FOR RECORD

JUL 20 11 20 AM '93

Sandy Schondelmarer
REGISTER OF DEEDS

002049

Register of Deeds Stamp & File Number

For corners in

BARRY
(County)

Located In:

Corner Code #

- | | | |
|------------------------------------|-------------------------|--------------------------------|
| 1. Public Land Survey | T <u>3N</u> R <u>8W</u> | <u>K-11</u> |
| | T _____ R _____ | <u>HASTINGS TOWNSHIP</u> |
| | T _____ R _____ | <u>(COR. SEC. 25 26 35 36)</u> |
| | T _____ R _____ | _____ |
| 2. Property Controlling in Section | S _____ T _____ R _____ | _____ |
| | S _____ T _____ R _____ | _____ |
| 3. Miscellaneous Property in Sec. | S _____ T _____ R _____ | _____ |
| | S _____ T _____ R _____ | _____ |

4. Lot No. _____, Recorded Plat _____
5. Private Claims _____

	A	B	C	D	E	F	G	H	I	J	K	L
2	6	5	4	3	2	1						
3												
4	7	8	9	10	11	12						
5												
6	18	17	16	15	14	13						
7												
8	19	20	21	22	23	24						
9												
10	30	29	28	27	26	25						
11												
12	31	32	33	34	35	36						
13												

BRIAN REYNOLDS JAN 93

I, BRIAN REYNOLDS, in a field survey on JAN, 1993, do hereby certify that under requirements of P.A. 74, Michigan P.A. of 1970, the corner points mentioned in lines 1 and 2 above were in conformance with regulations and rules therefore as required in the current manual of survey instructions of the United States Department of the Interior, Bureau of Land Management or by a decree of a Court of Law and/or that the corner points mentioned in lines 3, 4 and 5 above were in conformance with the rules of the Michigan Board of Land Surveyors or by a Decree of a Court of Law; established, re-established, monumented, re-monumented, recovered, found as expressed below:

NOTE: Not more than 4 corners, all in the same town and range, may be recorded on this certificate.


A. Description of original monument and accessories and/or subsequent restoration:

- | | | | |
|-------------------------|--------------------------------|-------------------------------|---------------------------------|
| G.L.O. : | Bowen 1878 (L.1, P.216) | Road Comm. | M.S.H.D. |
| Set post | Fnd. stake & brick | Spike & Stone | Spike over Stone |
| Y. Oak 7 N85E 45 | B. cherry 8 N50E 71 1/2 | T.P. N70E, 62.74' | Same Wit. as Road Comm. |
| W. Oak 8 N64W 47 | Aspen 11 S53 1/2E 66 | 26" maple S40E, 75.71 | (1965: N2W Boat Spike at |
| | | 24" maple S70W, 80.17' | 200' - 300' & 400') |
- Highway Constr. Plans**
Same Wit. as M.S.H.D.,
11.4' Lt. Sta: 169 + 48.46

B. Description of corner evidence found and/or method applied in restoring or reestablishing corner:

Found 3/4" Iron in monument box.
Fits M.D.O.T. stationing & centerline offset.

ALL PREVIOUS WITNESSES OBLITERATED

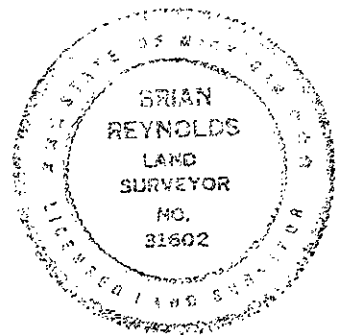

C. Description of monument for corner and accessories established to perpetuate locating the position of the corner:

- SET 3/4" IRON PIN, W/ALUM. REMON. CAP & PUNCH HOLE**
40 D NAIL W/BARRY Co. SHINER SE. SIDE UTIL. POLE N67E 199.72'
 " " " " " " **NW. SIDE " " N32E 163.58'**
 " " " " " " **W. SIDE " " N10W 172.41'**
 " " " " " " **W. FACE 26" MAPLE S10E 151.39'**
SE. CORNER PARTY STORE BLDG. (THORNAPPLE LAKE TRADING POST) N54E 276.82'

Signed by

Date 7-13-91

Surveyor's Michigan License No. 31602