

1993

COMMISSION

BARRY COUNTY REMONUMENTATION LAND CORNER RECORDATION CERTIFICATE Filing Requirement of Act 74, Mich. P.A. 1970

STATE OF MICHIGAN COUNTY OF BARRY RECEIVED FOR RECORD

JUL 20 11 20 AM '93

Sandy Schondelmayer REGISTER OF DEEDS

For corners in BARRY (County)

Located In: Corner Code #

- 1. Public Land Survey 3N 8W K-13 T R HASTINGS TWNSP (SE COR. SEC. 35) T R SW COR. SEC. 36)
2. Property Controlling in Section S T R
3. Miscellaneous Property in Sec. S T R

002045

Register of Deeds Stamp & File Number

- 4. Lot No. , Recorded Plat
5. Private Claims

Grid table with columns A-L and rows 2-13. A dot is present in the bottom right corner of the grid.

BRIAN REYNOLDS MAY 93

I, in a field survey on 19 do hereby certify that under requirements of P.A. 74, Michigan P.A. of 1970, the corner points mentioned in lines 1 and 2 above were in conformance with regulations and rules therefore as required in the current manual of survey instructions of the United States Department of the Interior, Bureau of Land Management or by a decree of a Court of Law and/or that the corner points mentioned in lines 3, 4 and 5 above were in conformance with the rules of the Michigan Board of Land Surveyors or by a Decree of a Court of Law; established, re-established, monumented, re-monumented, recovered, found as expressed below:

NOTE: Not more than 4 corners, all in the same town and range, may be recorded on this certificate.

A. Description of original monument and accessories and/or subsequent restoration:

- G.L.O.: Road Comm.
W. Oak 9 N36 1/2E 31 Pointed granite stone
Y. Oak 8 N75W 25 Corner post N45E, 36.8
" " S50W, 30.4
T. pole S45W, 48.8

B. Description of corner evidence found and/or method applied in restoring or reestablishing corner:


Found 1/2" iron. Fits doubling 1/8th line occupation from K-12. G.L.O. plat indicates closing corner E. 21links (13.86').

REYNOLDS (JAN 93)
FND. 1/2" IRON
8' +/- W. OF C-L CHARLTON PARK RD.
13' +/- S. OF C-L SAGER RD.
NAIL IN PAVEMENT - CL/CL - N55E - 15.99'
NW. SIDE - FENCE COR. - S45W - 35.53'
SE. SIDE - " " - N45E, 71.29'
CENTER TOP - " " - N45W, 57.77'
(40 D NAIL FOR WIT.)

C. Description of monument for corner and accessories established to perpetuate locating the position of the corner:

REPLACED FOUND 1/2" IRON WITH 3/4" IRON PIN, ALUM. REMON. CAP, AND PUNCH HOLE; REYNOLDS' (JAN 93) WITNESSES FOUND AND CHECKED; NEW WITNESSES:

- 40 D NAIL - BARRY Co. SHINER - N. FACE - 16" OAK - S60W - 127.51'
" " E. FACE - 16" CHOKE CHERRY - S15W - 121.51'

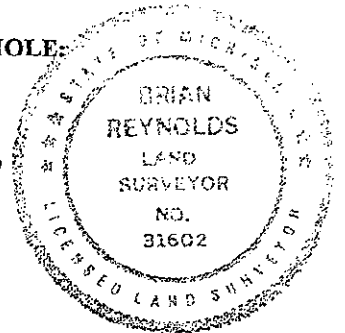

Signed by [Signature] Date 7-13-93
Surveyor's Michigan License No. 31602