

BARRY COUNTY REMONUMENTATION

LAND CORNER RECORDATION CERTIFICATE
Filing Requirement of Act 74, Mich. P.A. 1970

SURVEY &
REMONUMENTATION

APR 04 2000

SECTION

For Corners in BARRY Located In: Corner Code #
(county)

1. Public Land Survey T 3N R 8W L-13
SOUTH 1/2 CORNER OF T _____ R _____
SECTION 36 T _____ R _____
HASTINGS TOWNSHIP T _____ R _____
ON TOWNSHIP LINE

2. Property Controlling S _____ T _____ R _____
in Section S _____ T _____ R _____

3. Miscellaneous S _____ T _____ R _____



2793
Page: 1 of 1
11/16/1999 09:00A

Darla K. Burghdoff- Barry Co. LCRCR

Register of Deeds Stamp & File Number

4. Lot No _____, Recorded Plat _____
5. Private Claims _____

I, Brian Reynolds, in a field survey on 14 AUGUST, 1998 do hereby certify that under requirements of P.A. 74, Michigan P.A. of 1970, the corner points mentioned in lines 1 and 2 above were in conformance with regulations and rules therefore as required in the current manual of survey instructions of the United States Department of the Interior, Bureau of Land Management or by a decree of a Court of Law and/or that the corner points mentioned in lines 3, 4, and 5 above were in conformance with the rules of the Michigan Board of Land Surveyors or by a Decree of a Court of Law; established, re-established, monumented, re-monumented, recovered, found as expressed below.

NOTE: Not more than 2 corners, all in the same town and range, may be recorded on this certificate.

	A	B	C	D	E	F	G	H	I	J	K	L	M
1													
2	6	5	4	3	2	1							
3													
4	7	8	9	10	11	12							
5													
6	18	17	16	15	14	13							
7													
8	19	20	21	22	23	24							
9													
10	30	29	28	27	26	25							
11													
12	31	32	33	34	35	36							
13													

A. Description of original monument and accessories and/or subsequent restoration:

- GENERAL LAND OFFICE: JOHN MULLETT, D.S., 1826 (R8W, P.92) TAMK 7 N79E 48 Do. 18 N10W 18
- COUNTY SURVEYOR RECORDS: SETH PRATT, 13 OCT, 1884 (L. 2, P. 236) "FOUND U.S. BEARING PUT STAKE" NO WITNESSES REGARDING L-1 T2N R8W SHOWN FOR REFERENCE PURPOSES
- COUNTY SURVEYOR RECORDS: SETH PRATT, MARCH 1889 (L.2, P.265) "FOUND BY U.S. BEARING. PLACED POST 10 1/2 LKS. EAST OF HASTINGS POST. MADE NEW BEARING" TAMARACK 18 N35 1/2 W 21 1/2 LKS DEAD
- LAND CORNER RECORDATION CERTIFICATE: #238 BY MILTON E. DEKEYSER, P.S. #12019, 10 JUNE, 1975, "FOUND TILE AT FENCE CORNER W/ FENCE WEST, SOUTH AND SOUTHEAST (APPARENTLY SET IN RESURVEY, 1826)" NO WITNESSES GIVEN
- PRIVATE NOTES: FROM THE DEKEYSER FILES, P. McPHERSON, JUNE 1975, "TILE W/IRON IN FENCE CORNER. IN FENCE CORNER WITH FENCE SOUTH WEST & SOUTHEAST"

B. Description of corner evidence found and/or method applied in restoring or reestablishing corner:

FOUND FENCE CORNER IN SWAMP AS DESCRIBED IN ITEMS 4 & 5 ABOVE. (FOUND NEITHER TILE NOR IRON). AFTER TRAVERSE OF ALL OF SECTION 1 T2N R8W, ACCEPTED FENCE CORNER AS BEST AVAILABLE EVIDENCE OF POSITION OF TILE & IRON AS RECITED BY DeKEYSER. RESTORED L-1 AS DESCRIBED. RESTORED L-13 6.93 FEET (10 1/2 LINKS) WEST OF RESTORED L-1.


L-13 TO M-13 S89°49'50"E, 2657.83' L-13 TO K-13 N89°48'51"W, 2653.51'

C. Description of monument for corner and accessories established to perpetuate locating the position of the corner:

SET STANDARD BARRY COUNTY REMONUMENTATION MONUMENT (3/4" X 36" IRON) WITH ALUMINUM CAP.
SET 20d NAIL W/PLASTIC TAG IN THE WEST SIDE OF A 20" WILLOW N54°E 41.24'
SET 20d NAIL W/PLASTIC TAG IN THE NORTHEAST SIDE OF A 4" ELM S66°E 76.87'
SET 20d NAIL W/PLASTIC TAG IN THE EAST SIDE OF A 10" POPLAR S30°E 88.12'
SET 20d NAIL W/PLASTIC TAG IN THE WEST SIDE OF A 10" POPLAR S29°E 56.49'
SET 20d NAIL W/PLASTIC TAG IN THE NORTHWEST SIDE OF A 12" WILLOW S28°W 76.71'
CORNER LIES 7+/- WEST OF A DECAYING FENCES RUNNING SOUTH AND SOUTHEAST
IN A DECAYING FENCE EAST-WEST, ABOUT 19 FEET WEST OF BADLY DECAYING FENCE NORTH.
L-1, TN, R8W, LIES EAST 6.93'

ACT 305 BARRY COUNTY REMONUMENTATION
APPROVED BY PEER REVIEW AT A MEETING HELD ON

8 June 98 BR
BRIAN REYNOLDS COUNTY SURVEYOR

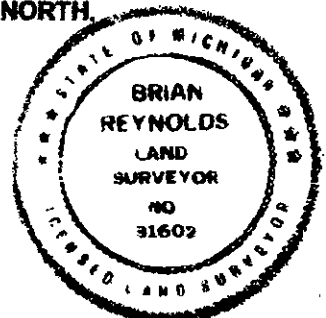

Signed by [Signature]
Surveyor's Michigan License No. 31602

Date 11/15/1999