

SURVEY & REMONUMENTATION

AUG 22 1995

COMMISSION

BARRY COUNTY REMONUMENTATION

STATE OF MICHIGAN COUNTY OF BARRY RECEIVED FOR RECORD

JAN 25 8 35 AM '95

Sandy Schondelmarzen REGISTER OF DEEDS

LAND CORNER RECORDATION CERTIFICATE Filing Requirement of Act 74, Mich. P.A. 1970

For corners in BARRY

(County)

Located in:

Corner Code #

Table with 3 columns: Description, T, R, Corner Code. Row 1: Public Land Survey WEST 1/4 CORNER SECTION 6, T 3N, R 9W, A-2. Row 2: RUTLAND TOWNSHIP. Row 3: ON RANGE LINE. Row 4: Property Controlling in Section. Row 5: Miscellaneous Property in Sec.

002275

Register of Deeds Stamp & File Number

4. Lot No. , Recorded Plat 5. Private Claims

Grid table with columns A-L and rows 2-13. Cell (2,6) contains a circle with a dot.

BRIAN REYNOLDS in a field survey on 20 OCTOBER 1994

do hereby certify that under requirements of P.A. 74, Michigan P.A. of 1970, the corner points mentioned in lines 1 and 2 above were in conformance with regulations and rules therefore as required in the current manual of survey instructions of the United States Department of the Interior, Bureau of Land Management or by a decree of a Court of Law and/or that the corner points mentioned in lines 3, 4 and 5 above were in conformance with the rules of the Michigan Board of Land Surveyors or by a Decree of a Court of Law; established, re-established, monumented, re-monumented, recovered, found as expressed below:

NOTE: Not more than 4 corners, all in the same town and range, may be recorded on this certificate.

A. Description of original monument and accessories and/or subsequent restoration:

- 1 CORNER NOT SET BY GENERAL LAND OFFICE
2 LAND CORNER RECORDATION CERTIFICATE: #274, BY DOUGLAS W. BONNEMA, P.S. #12579, JUNE 28, 1979, "SET CAPPED RE-ROD. SET POINT ON LINE WITH SECTION CORNERS AND BY PRORATING GOVERNMENT DISTANCES TO EACH CORNER." COR. FENCE POST 3' SOUTH (FENCE TO N-&WEST) C/L CONC. R/W MARKER SSW 3.6' PK IN SDE GUY POLE SOUTH 8.48' PK IN SDE P. POLE SSW 22.25' SPIKE IN SDE 40" OAK SW 38.85'
3 SURVEY BY CHARLES E. FRICKE, P.S. #21781, (ACT 132 SURVEY, L.1.P.846-847) WITNESSES SAME AS IN 2 ABOVE

B. Description of corner evidence found and/or method applied in restoring or reestablishing corner:


FOUND CAPPED IRON. CONFIRMED WITNESSES BY BONNEMA AND FRICKE. COMPUTED POSITION FOR PRORATION ON LINE IS 0.18' SOUTH AND 0.09' WEST OF IRON BY BONNEMA, WELL WITHIN ANY STANDARDS. ACCEPTED IRON BY BONNEMA AS A PROPER RESTORATION OF THE CORNER. REPLACED IRON BY BONNEMA WITH STANDARD BARRY COUNTY REMONUMENTATION MONUMENT.

ACT 345 BARRY COUNTY REMONUMENTATION APPROVED BY PEER REVIEW AT A MEETING HELD ON

1 Nov. 1994 BRIAN REYNOLDS COUNTY SURVEYOR

C. Description of monument for corner and accessories established to perpetuate locating the position of the corner:

SET STANDARD BARRY COUNTY REMONUMENTATION MONUMENT (3/4"X36"W/ALUMINUM CAP) FOUND NAIL IN THE SOUTHEAST SIDE OF A 40" OAK S68°W 38.98' FOUND PK W/SHINER IN THE EAST SIDE OF A UTILITY POLE S25°W 22.29' TOP CENTER OF A CONCRETE R/W MARKER S20°W 3.55' 53' NORTH OF THE CENTERLINE OF M-37 IN FENCE TO THE NORTH, 3' NORTH OF THE CORNER POST

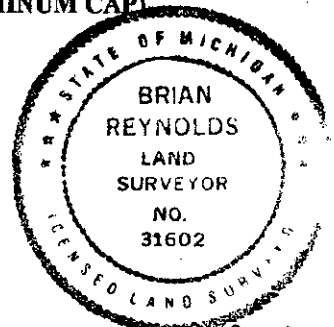

Signed by [Signature] Surveyor's Michigan License No. 31602

Date JANUARY 24, 1995