

SURVEY & REMONUMENTATION

AUG 22 1995

COMMISSION

BARRY COUNTY REMONUMENTATION

STATE OF MICHIGAN COUNTY OF BARRY RECEIVED FOR RECORD

JAN 25 8 34 AM '95

Sandy Schindelmarer REGISTER OF DEEDS

LAND CORNER RECORDATION CERTIFICATE Filing Requirement of Act 74, Mich. P.A. 1970

For corners in BARRY

(County)

Located In:

Corner Code #

- 1. Public Land Survey CORNER COMMON TO SECTIONS 7 & 18 RUTLAND TOWNSHIP ON RANGE LINE T 3N R 9W A-5
2. Property Controlling in Section S T R
3. Miscellaneous Property in Sec. S T R

002272

Register of Deeds Stamp & File Number

- 4. Lot No. , Recorded Plat
5. Private Claims

Grid table with columns A-M and rows 2-13, containing numbers 1-36.

BRIAN REYNOLDS

22 OCTOBER

1994

I, BRIAN REYNOLDS, in a field survey on 22 OCTOBER 1994, do hereby certify that under requirements of P.A. 74, Michigan P.A. of 1970, the corner points mentioned in lines 1 and 2 above were in conformance with regulations and rules therefore as required in the current manual of survey instructions of the United States Department of the Interior, Bureau of Land Management or by a decree of a Court of Law and/or that the corner points mentioned in lines 3, 4 and 5 above were in conformance with the rules of the Michigan Board of Land Surveyors or by a Decree of a Court of Law; established, re-established, monumented, re-monumented, recovered, found as expressed below:

NOTE: Not more than 4 corners, all in the same town and range, may be recorded on this certificate.

A. Description of original monument and accessories and/or subsequent restoration:

- 1 GENERAL LAND OFFICE: SYLVESTER SIBLEY, D.S., 1831 (R9W,P.141), WEST 81.41 INTERSECTED W. BOUNDARY 59 NORTH OF POST. A. Y. OAK 9. N76 1/2E. 110 Do. 10 S.41 1/2E. 101
2 COUNTY SURVEYOR RECORDS: LEE S. COBB, 1895 (L.2,P.283) FOUND OLD STAKE & ONE STUMP OF U.S. TREE OAK N.E. SET IRON STAKE 2 X 26in & BRICK IN PLACE OF STAKE
4 NO OTHER RECORDED HISTORICAL INFORMATION AVAILABLE FOR THIS CORNER


B. Description of corner evidence found and/or method applied in restoring or reestablishing corner:

FOUND 2" X 26" SOLID IRON, APPROXIMATELY ON EXTENDED CENTERLINE OF GRAVEL ROAD EAST. REPLACED 2" X 26" SOLID IRON WITH STANDARD BARRY COUNTY REMONUMENTATION MONUMENT.

ACT 345 BARRY COUNTY REMONUMENTATION APPROVED BY PEER REVIEW AT A MEETING HELD ON

1 NOV. 1994

BR COUNTY SURVEYOR

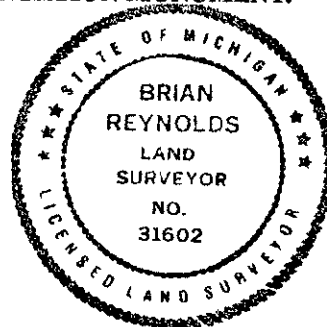

C. Description of monument for corner and accessories established to perpetuate locating the position of the corner:

SET STANDARD BARRY COUNTY REMONUMENTATION MONUMENT (3/4"X36"W/ALUMINUM CAP) SET 40d NAIL W/PLASTIC TAG IN THE SOUTH SIDE OF A UTILITY POLE N63°W 82.59' SET 40d NAIL W/PLASTIC TAG IN THE NORTHEAST SIDE OF A UTILITY POLE N39°W 73.48' SET 40d NAIL W/PLASTIC TAG IN THE WEST SIDE OF A 14" OAK N20°E 67.15' SET 40d NAIL W/PLASTIC TAG IN THE NORTHEAST SIDE OF A UTILITY POLE S47°E 60.03' ROUGHLY ON CENTERLINE OF PEETS ROAD 20' NORTH OF THE CENTERLINE OF BOWEN'S MILL ROAD 38.94' NORTH OF THE SOUTHEAST CORNER OF SECTION 12, T3N, R10W

Signed by [Signature] Surveyor's Michigan License No. 31602

Date JANUARY 24, 1995