

REMONUMENTATION
AUG 22 1995
COMMISSION

BARRY COUNTY REMONUMENTATION

STATE OF MICHIGAN
COUNTY OF BARRY
RECEIVED FOR RECORD
JAN 25 8 34 AM '95
Sandy Schindelmayer
REGISTER OF DEEDS

LAND CORNER RECORDATION CERTIFICATE
Filing Requirement of Act 74, Mich. P.A. 1970

For corners in
BARRY
(County)

Located In:	Corner Code #
T <u>3N</u> R <u>9W</u>	<u>B-3</u>
T _____ R _____	_____
T _____ R _____	_____
T _____ R _____	_____
S _____ T _____ R _____	_____
S _____ T _____ R _____	_____
S _____ T _____ R _____	_____
S _____ T _____ R _____	_____

002271

Register of Deeds Stamp & File Number

1. Public Land Survey
**1/4 CORNER COMMON TO
SECTIONS 6 & 7
RUTLAND TOWNSHIP**

4. Lot No. _____, Recorded Plat _____
5. Private Claims _____

I, **BRIAN REYNOLDS**, in a field survey on **22 OCTOBER**, 19 **1994**, do hereby certify that under requirements of P.A. 74, Michigan P.A. of 1970, the corner points mentioned in lines 1 and 2 above were in conformance with regulations and rules therefore as required in the current manual of survey instructions of the United States Department of the Interior, Bureau of Land Management or by a decree of a Court of Law and/or that the corner points mentioned in lines 3, 4 and 5 above were in conformance with the rules of the Michigan Board of Land Surveyors or by a Decree of a Court of Law; established, re-established, monumented, re-monumented, recovered, found as expressed below:

A	B	C	D	E	F	G	H	I	J	K	L	M
2	6	5	4	3	2	1						
3												
4	7	8	9	10	11	12						
5												
6	18	17	16	15	14	13						
7												
8	19	20	21	22	23	24						
9												
10	30	29	28	27	26	25						
11												
12	31	32	33	34	35	36						
13												

NOTE: Not more than 4 corners, all in the same town and range, may be recorded on this certificate.

A. Description of original monument and accessories and/or subsequent restoration:

- GENERAL LAND OFFICE: SYLVESTER SIBLEY, D.S., 1831 (R9W,P.142), A. W. OAK S S25 1/2W 2.87 Do. 15 N55W 3.59
- COUNTY SURVEYOR RECORDS: A.N. BATEMAN, MAR. 30, 1902 (L.3,P.62) "STAKE 6" OAK S83°W 151 1/2 ft."
- ALSO: A.N. BATEMAN, SEPT. 8,9,10, 1902 (L.3,P.76) "STAKE"
- LAND CORNER RECORDATION CERTIFICATE: #274, BY DOUGLAS BONNEMA, P.S.#12579, JUNE 8, 1979 "SET CAPPED RE-ROD. SET POINT ON LINE WITH SECTION CORNERS AND BY PRORATING GOVERNMENT DISTANCES TO EACH CORNER."
- C/L OF 16'+/- WIDE MOUND OF DIRT BETWEEN 2 SWAMPS SOUTH 8'+/- SPIKE IN SDE 8" ELM SW 15.94' SOUTH EDGE OF WATER NORTH 1'+/-
- SURVEY BY CHARLES E. FRICKE, P.S.#21781, OCT. 27, 1986 (ACT 132 SURVEY, L.1, P.846-847) "S. 1/4 COR. OF SEC. 6: 8" ELM S.W. 15.54"
- NO OTHER RECORDED HISTORICAL INFORMATION AVAILABLE FOR THIS CORNER

B. Description of corner evidence found and/or method applied in restoring or reestablishing corner:

FOUND CAPPED IRON. CONFIRMED WITNESSES BY FRICKE AND BONNEMA. COMPLETE TRAVERSE OF SECTION 7 CONFIRMED PROPER PROPORTIONING AND POSITIONING BY BONNEMA, WITH DISTANCES CONFORMING REMARKABLY WELL WITH THE SURVEY BY BATEMAN, L.3, P.62., 1902 ACCEPTED FOUND CAPPED IRON AS A PROPER RESTORATION OF THE CORNER. REPLACED CAPPED IRON WITH STANDARD BARRY COUNTY REMONUMENTATION MONUMENT.


ACT 345 BARRY COUNTY REMONUMENTATION
APPROVED BY PEER REVIEW AT A MEETING HELD ON

1 NOV. 1994 BR
BRIAN REYNOLDS COUNTY SURVEYOR

C. Description of monument for corner and accessories established to perpetuate locating the position of the corner:

**SET STANDARD BARRY COUNTY REMONUMENTATION MONUMENT (3/4"X36"W/ALUMINUM CAP)
SET 40d NAIL W/PLASTIC TAG IN THE NORTH SIDE OF A 12" ELM S85°W 15.81'
1' SOUTH OF THE EDGE OF THE WATER
8' NORTH OF THE CENTERLINE OF A 16' BERM (EAST-WEST) BETWEEN TWO SWAMPS**

SEE REVERSE SIDE OF THIS FORM FOR MORE INFORMATION

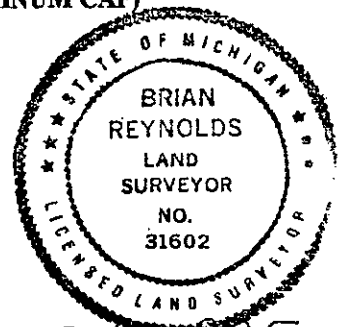

Signed by [Signature]
Surveyor's Michigan License No. 31602

Date JANUARY 21, 1995

