

SURVEY &  
REMONUMENTATION

AUG 22 1995

COMMISSION

**BARRY COUNTY REMONUMENTATION**

STATE OF MICHIGAN  
COUNTY OF BARRY  
RECEIVED FOR RECORD

JAN 25 8 34 AM '95

Sandy Schondelmayer  
REGISTER OF DEEDS

**LAND CORNER RECORDATION CERTIFICATE**  
Filing Requirement of Act 74, Mich. P.A. 1970

For corners in  
**BARRY**

(County)

Located In:

Corner Code #

|                                  |   |           |   |           |            |
|----------------------------------|---|-----------|---|-----------|------------|
| 1. Public Land Survey            | T | <u>3N</u> | R | <u>9W</u> | <u>C-5</u> |
| <b>CORNER COMMON TO</b>          | T | _____     | R | _____     | _____      |
| <b>SECTIONS 7,8,17, &amp; 18</b> | T | _____     | R | _____     | _____      |
| <b>RUTLAND TOWNSHIP</b>          | T | _____     | R | _____     | _____      |
| 2. Property Controlling          | S | _____     | R | _____     | _____      |
| in Section                       | S | _____     | R | _____     | _____      |
| 3. Miscellaneous                 | S | _____     | R | _____     | _____      |
| Property in Sec.                 | S | _____     | R | _____     | _____      |

002266

Register of Deeds Stamp & File Number

- 4. Lot No. \_\_\_\_\_, Recorded Plat \_\_\_\_\_
- 5. Private Claims \_\_\_\_\_

| A  | B  | C  | D  | E  | F  | G  | H | I | J | K | L | M |
|----|----|----|----|----|----|----|---|---|---|---|---|---|
| 2  | 6  | 5  | 4  | 3  | 2  | 1  |   |   |   |   |   |   |
| 3  |    |    |    |    |    |    |   |   |   |   |   |   |
| 4  | 7  | 8  | 9  | 10 | 11 | 12 |   |   |   |   |   |   |
| 5  |    |    |    |    |    |    |   |   |   |   |   |   |
| 6  | 18 | 17 | 16 | 15 | 14 | 13 |   |   |   |   |   |   |
| 7  |    |    |    |    |    |    |   |   |   |   |   |   |
| 8  | 19 | 20 | 21 | 22 | 23 | 24 |   |   |   |   |   |   |
| 9  |    |    |    |    |    |    |   |   |   |   |   |   |
| 10 | 30 | 29 | 28 | 27 | 26 | 25 |   |   |   |   |   |   |
| 11 |    |    |    |    |    |    |   |   |   |   |   |   |
| 12 | 31 | 32 | 33 | 34 | 35 | 36 |   |   |   |   |   |   |
| 13 |    |    |    |    |    |    |   |   |   |   |   |   |

I, **BRIAN REYNOLDS**, in a field survey on **20 OCTOBER**, 19**1994**

do hereby certify that under requirements of P.A. 74, Michigan P.A. of 1970, the corner points mentioned in lines 1 and 2 above were in conformance with regulations and rules therefore as required in the current manual of survey instructions of the United States Department of the Interior, Bureau of Land Management, or by a decree of a Court of Law and/or that the corner points mentioned in lines 3, 4 and 5 above were in conformance with the rules of the Michigan Board of Land Surveyors or by a Decree of a Court of Law; established, re-established, monumented, re-monumented, recovered, found as expressed below:

**NOTE: Not more than 4 corners, all in the same town and range, may be recorded on this certificate.**

A. Description of original monument and accessories and/or subsequent restoration:

- 1 GENERAL LAND OFFICE: SYLVESTER SIBLEY, D.S., 1831 (R9W, P.140), A. W. OAK 10 S52E 15 Do. 12 S40W 46
- 2 COUNTY SURVEYOR RECORDS: A.N. BATEMAN, MAR. 30, 1902 (L.3, P.62) "IRON" N44°E 46 1/2 Ft. 12" OAK
- 3 SURVEY BY DOUGLAS W. BONNEMA, P.S. #12579, DEC. 29, 1978 (ACT 132 SURVEY L.1, P.490) "REROD" NAIL & TAG IN NE SIDE 16" OAK NW 60.17' NAIL & TAG IN SE. SIDE 16" WALNUT NNE. 89.01' NAIL & TAG IN S SIDE FNC POST E. 32.41' ON C/L N.-S. BIT. ROAD & ON LINE WITH FNC. TO E.
- 4 LAND CORNER RECORDATION CERTIFICATE: #221 BY DOUGLAS W. BONNEMA, 14 NOVEMBER, 1977, "3/8 RE-ROD" WITNESSES SAME AS IN 3 ABOVE.
- 5 UNRECORDED SURVEY BY BRIAN REYNOLDS, P.S. #31602, FEBRUARY 1990, REFERS TO LAND CORNER RECORDATION CERTIFICATE #221, NOT REWITNESSED.
- 6 NO OTHER RECORDED HISTORICAL INFORMATION AVAILABLE FOR THIS CORNER

B. Description of corner evidence found and/or method applied in restoring or reestablishing corner:

**FOUND IRON IN BITUMINOUS ROADWAY BY BONNEMA. FOUND ALL WITNESSES EXCEPT OAK NORTHWEST. TRAVERSED SECTION 7, MEASUREMENTS CHECK VERY WELL WITH PRIOR SURVEYS. ACCEPTED IRON AS PROPER RESTORATION OF CORNER. REPLACED IRON WITH STANDARD BARRY COUNTY REMONUMENTATION MONUMENT, AND INSTALLED MONUMENT BOX.**


ACT 345 BARRY COUNTY REMONUMENTATION  
APPROVED BY PEER REVIEW AT A MEETING HELD ON

6 Dec 1994  
BRIAN REYNOLDS

BR  
COUNTY SURVEYOR

C. Description of monument for corner and accessories established to perpetuate locating the position of the corner:

- SET STANDARD BARRY COUNTY REMONUMENTATION MONUMENT (3/4"X36"W/ALUMINUM CAP)
- SET 40d NAIL W/REMON TAG IN THE WEST SIDE OF A 6" BLACK WALNUT S54°W 74.88'
- SET 40d NAIL W/REMON TAG IN THE SOUTHWEST SIDE OF A 6" OAK N49°W 68.49'
- SET 40d NAIL W/REMON TAG IN THE EAST SIDE OF A 20" BLACK WALNUT S17°E 105.77'
- SET 40d NAIL W/REMON TAG IN THE EAST SIDE OF A 20" BLACK WALNUT S12°E 147.42'
- CORNER LIES 0.5' WEST OF PAINTED CENTERLINE OF WHITMORE ROAD

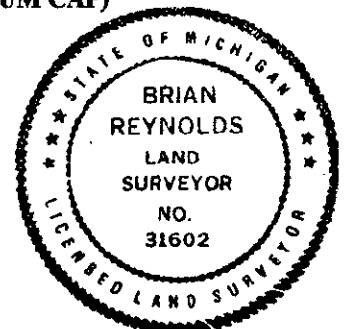

Signed by Brian Reynolds  
Surveyor's Michigan License No. 31602

Date JANUARY 24, 1995