

**SURVEY & REMONUMENTATION**

APR 26 1995

**COMMISSION**

**Barry County Remonumentation  
LAND CORNER RECORDATION CERTIFICATE  
Filing Requirement of Act 74, Mich. P.A. 1970**

STATE OF MICHIGAN  
COUNTY OF BARRY  
RECEIVED FOR RECORD

DEC 8 8 15 AM '94


Sandy Schondelmar  
REGISTER OF DEEDS

002254

Register of Deeds Stamp & File Number

For corners in Barry (County)	Located In:	Corner Code #/
Public Land Survey	T 3N R 9W	E-6 (E $\frac{1}{2}$ , 17) Rutland Twp.
	T _____ R _____	_____
	T _____ R _____	_____
	T _____ R _____	_____
Property Controlling in Section	S _____ T _____ R _____	_____
	S _____ T _____ R _____	_____
Miscellaneous Property in Sec.	S _____ T _____ R _____	_____
	S _____ T _____ R _____	_____

Lot No. \_\_\_\_\_, Recorded Plat \_\_\_\_\_  
Private Claims \_\_\_\_\_

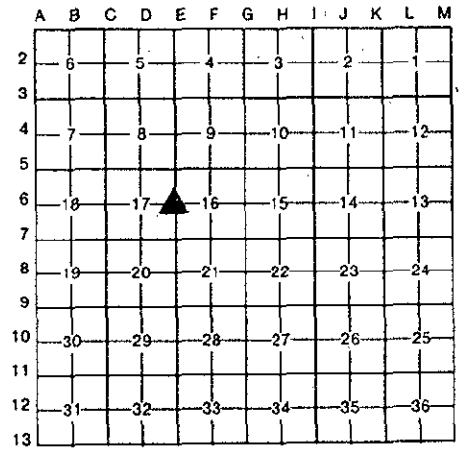

John C. Bueche, in a field survey on October, 19 94,  
hereby certify that under requirements of P.A. 74, Michigan P.A. of 1970, the corner points mentioned  
in lines 1 and 2 above were in conformance with regulations and rules therefore as required in the  
current manual of survey instructions of the United States Department of the Interior, Bureau of Land  
Management or by a decree of a Court of Law and/or that the corner points mentioned in lines 3, 4 and 5  
above were in conformance with the rules of the Michigan Board of Land Surveyors or by a Decree of a  
court of Law; established, re-established, monumented, re-monumented, recovered, found as  
expressed below:

**NOTE: Not more than 4 corners, all in the same town and range, may be recorded  
on this certificate.**

Description of original monument and accessories and/or subsequent restoration:

E-6 GLO	LCRC #222, Nov., 1977
A.W. Oak 12" S 58° E 24 lks.	Capped iron
A.W. Oak 16" N 44° W 12 lks.	Nail in side 12" Oak SW 32.08'
Sylvester Sibley, D.S., 1831	Nail in side 28" Oak WNW 80.67'
	Nail in side 20" Oak NNW 34.59'
	Nail in side 16" Oak N 5° E 51.57'
	Iron on C/L bit.

Description of corner evidence found and/or method applied in restoring or reestablishing corner:

E-6 Found 1" pipe in Mon. Box 1'± N of C/L bit.  
28" Oak WNW 80.6'±  
Nail & Cap in E side 20" Oak NNW 34.59'  
16" Oak NNW 51.6'±  
And is accepted as a careful and faithful perpetuation of the position  
of the original corner.

ACT 345 BARRY COUNTY REMONUMENTATION  
APPROVED BY PEER REVIEW AT A MEETING HELD ON

4 OCT 94 BR  
BRIAN REYNOLDS COUNTY SURVEYOR

Description of monument for corner and accessories established to perpetuate locating the position of the corner:

E-6 Replaced 1" iron with Std. Barry Co. Mon. (3/4" x 24" Pin with  
Alum. Cap)  
Nail & Barry Co. Remon. Tag in E side 30" Oak N 25° W 34.37'  
Nail & Barry Co. Remon. Tag in E side 22" Oak N 10° E 51.18'  
Nail & Barry Co. Remon. Tag in SW side 12" Oak S 50° E 57.45'  
40d Nail & RS Cap #31602 in W side 12" Walnut S 5° W 42.16'  
C/L bit. rd. E-W, South 1'±, on tree line N & S

Surveyed by John C Bueche  
Surveyor's Michigan License No. 13027

Date 10-26-94

