

SURVEY & REMONUMENTATION

NOV 04 1996

COMMISSION

BARRY COUNTY REMONUMENTATION

**LAND CORNER RECORDATION CERTIFICATE
Filing Requirement of Act 74, Mich. P.A. 1970**

STATE OF MICHIGAN
COUNTY OF BARRY
RECEIVED FOR RECORD

AUG 20 11 27 AM '96

Sandy Schondelmarer
REGISTER OF DEEDS

002400

Register of Deeds Stamp & File Number

For corners in
BARRY
(County)

Located In: Corner Code #

- | | | | | | |
|--|---|-----------|---|-----------|------------|
| 1. Public Land Survey | T | <u>3N</u> | R | <u>9W</u> | <u>I-1</u> |
| CORNER COMMON TO SECTIONS 2 & 3 RUTLAND TOWNSHIP ON TOWNSHIP LINE | T | | R | | |
| | T | | R | | |
| | T | | R | | |
| 2. Property Controlling in Section | S | | T | | R |
| | S | | T | | R |
| 3. Miscellaneous Property in Sec. | S | | T | | R |
| | S | | T | | R |

4. Lot No. _____, Recorded Plat _____
5. Private Claims _____

	A	B	C	D	E	F	G	H	I	J	K	L	M
2	6		5		4		3		2		1		
3													
4	7		8		9		10		11		12		
5													
6	18		17		16		15		14		13		
7													
8	19		20		21		22		23		24		
9													
10	30		29		28		27		26		25		
11													
12	31		32		33		34		35		36		
13													

BRIAN REYNOLDS 31 MARCH 19 95


I, BRIAN REYNOLDS, in a field survey on 31 MARCH, 1995, do hereby certify that under requirements of P.A. 74, Michigan P.A. of 1970, the corner points mentioned in lines 1 and 2 above were in conformance with regulations and rules therefore as required in the current manual of survey instructions of the United States Department of the Interior, Bureau of Land Management or by a decree of a Court of Law and/or that the corner points mentioned in lines 3, 4 and 5 above were in conformance with the rules of the Michigan Board of Land Surveyors or by a Decree of a Court of Law; established, re-established, monumented, re-monumented, recovered, found as expressed below:

NOTE: Not more than 4 corners, all in the same town and range, may be recorded on this certificate.

A. Description of original monument and accessories and/or subsequent restoration

GENERAL LAND OFFICE: SYLVESTER SIBLEY, D.S., 1831(R9W,P.126)
"NORTH 81.34 INTERSECTED N. BOUNDARY 4 Lks W. OF P."
A. W. OAK 20 N64 1/2E 150 A. B. OAK 22 S44 1/2W 75
COUNTY SURVEYOR RECORDS: JAMES H. BROWN(L.2,P.30)
W. OAK 4 N71W 95 B. OAK 3 S61 1/2W 46

NO OTHER RECORDED HISTORICAL INFORMATION AVAILABLE FOR THIS CORNER

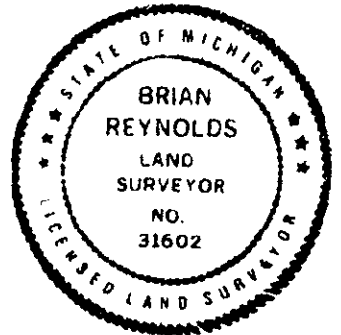

B. Description of corner evidence found and/or method applied in restoring or reestablishing corner.

FOUND 3/4" IRON PIPE, BUT COULD FIND NO RECORD SUPPORTING IT. MEASUREMENTS ALONG TOWNSHIP LINE ONE MILE WEST AND TWO MILES EAST, TYING IN FOUND STANDARD AND CLOSING CORNERS AND OCCUPATION LINES, INDICATE THE OCCUPATION FENCE NORTH, APPROXIMATELY 25 FEET EAST OF FOUND PIPE CORRESPONDS WITH SECTION LINE BETWEEN SECTION 34 AND 35, T4N R9W. A VAGUE OCCUPATION LINE SOUTH (MARGIN BETWEEN TWO CULTIVATED FIELDS) WOULD BE CONSISTANT WITH EITHER THE FOUND PIPE OR A POSITION DETERMINED BY THE GOVERNMENT JOG, APPROXIMATELY 20 FEET EAST OF THE FOUND PIPE. MEASUREMENTS TO OCCUPATION LINES AND RESTORED CORNERS 1/4 MILE WEST (MARGIN BETWEEN FIELDS), 1/2 MILE WEST (OLD OCCUPATION FENCE), AND ONE MILE WEST (RESTORED CORNER), CONFLICT, ONE WITH ANOTHER. THE FENCE 1/2 MILE WEST IS WITHIN 1/2 FOOT OF MIDWAY BETWEEN THE RESTORED CORNER AT G-1 AND THE POSITION DETERMINED BY THE GOVERNMENT JOG.

THE OCCUPATION LINE 1/4 MILE WEST, VAGUE AT BEST, WOULD TEND TO CONFIRM THE POSITION OF THE FOUND PIPE, BEING WITHIN 2 FEET OF MIDWAY BETWEEN THE FOUND PIPE AND THE OLD OCCUPATION FENCE. TIED INTO PLAT MONUMENTS AND I-2. RESULTS SUPPORT THE LOCATION OF STANDARD CORNER IN LINE WITH FENCE NORTH. RESTORED CORNER BY INTERSECTING PLAT LINE AND TOWN LINE, DISREGARDED FOUND PIPE.

- C. Description of monument for corner and accessories established to perpetuate locating the corner:
- SET STANDARD BARRY COUNTY REMONUMENTATION MONUMENT (3/4"X36"W/ALUMINUM CAP)
 - SET 40d NAIL W/PLASTIC TAG IN THE SOUTH SIDE OF A 30" MAPLE N66°W 76.28'
 - CENTER OF A 3/4" IRON BAR IN THE TOP OF A 12"x12" CONCRETE FENCE CORNER POST N1°W 30.61'
 - SET 40d NAIL W/PLASTIC TAG IN THE NORTHWEST SIDE OF A UTILITY POLE N55°E 93.67'
 - SET 40d NAIL W/PLASTIC TAG IN THE SOUTH SIDE OF A 6" MAPLE N67°E 75.05'
 - SET 40d NAIL W/PLASTIC TAG IN THE NORTH SIDE OF A UTILITY POLE S67°E 94.94'
 - I-13 T4N, R9W, IRVING TOWNSHIP EAST 2.64'

ACT 345 BARRY COUNTY REMONUMENTATION
APPROVED BY PEER REVIEW AT A MEETING HELD ON
APRIL 10, 1995 BR
BRIAN REYNOLDS COUNTY SURVEYOR

Signed by [Signature]
Surveyor's Michigan License No. 31602

Date AUGUST 10, 1996