

DEC 17 1 09 PM '93

Sandy Schondelmayer  
 REGISTER OF DEEDS

LAND CORNER RECORDATION CERTIFICATE  
 Filing Requirement of Act 74, Mich. P.A. 1970

For corners in

Barry County  
(County)  
Rutland Township

Located In: Corner Code #

- |                                    |                         |                     |
|------------------------------------|-------------------------|---------------------|
| 1. Public Land Survey              | T <u>3N</u> R <u>9W</u> | I-9                 |
|                                    | T _____ R _____         | Sec. Corner common  |
|                                    | T _____ R _____         | to Sections 22, 23, |
|                                    | T _____ R _____         | 26 and 27           |
| 2. Property Controlling in Section | S _____ T _____ R _____ |                     |
|                                    | S _____ T _____ R _____ |                     |
| 3. Miscellaneous Property in Sec.  | S _____ T _____ R _____ |                     |
|                                    | S _____ T _____ R _____ |                     |

002181

Register of Deeds Stamp & File Number

4. Lot No. \_\_\_\_\_, Recorded Plat \_\_\_\_\_
5. Private Claims \_\_\_\_\_

	A	B	C	D	E	F	G	H	I	J	K	L	M
2	6		5		4		3		2		1		
3													
4	7		8		9		10		11		12		
5													
6	18		17		16		15		14		13		
7													
8	19		20		21		22		23		24		
9													
10	30		29		28		27		26		25		
11													
12	31		32		33		34		35		36		
13													

Kenneth C.

I, Brandt, in a field survey on November 20, 1993, do hereby certify that under requirements of P.A. 74, Michigan P.A. of 1970, the corner points mentioned in lines 1 and 2 above were in conformance with regulations and rules therefore as required in the current manual of survey instructions of the United States Department of the Interior, Bureau of Land Management or by a decree of a Court of Law and/or that the corner points mentioned in lines 3, 4 and 5 above were in conformance with the rules of the Michigan Board of Land Surveyors or by a Decree of a Court of Law; established, re-established, monumented, re-monumented, recovered, found as expressed below:

NOTE: Not more than 4 corners, all in the same town and range, may be recorded on this certificate.

A. Description of original monument and accessories and/or subsequent restoration:

Stone found by A.N. Bateman (May 1902) only Witness: 6" Hickory N.7° E. 7 feet

B. Description of corner evidence found and/or method applied in restoring or reestablishing corner:

Found 6"x8"x16" Stone approx. 4" high with pieces of red brick at buried end. 30" diameter shag bark hickory found N.7° E. 7 feet believed to be witness tree described above. 2" steel angle corner post 0.3' East to fences running North, South and East.

SURVEY &  
 REMONUMENTATION

APR 05 1994


COMMISSION

C. Description of monument for corner and accessories established to perpetuate locating the position of the corner:

Removed stone and brick pieces, and replaced with 3/4" iron pin with Aluminum Remonumentation cap with punch mark. Fences North, East and South and down fence to West.

Nail and Barry County remon shiners placed as follows:

- W. side of 12" Red Oak SOUTH 20.34'
- W. side of 6" Red Oak WEST 24.05'
- W. side of 30" Hickory N.7° E. 7.16'
- S. side of 10" Red Oak S.88° E. 37.84'

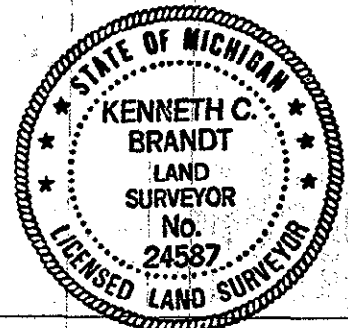

Signed by Kenneth C. Brandt

Date 12/15/93

Surveyor's Michigan License No. 24587