

NOV 04 1996

COMMISSION

BARRY COUNTY REMONUMENTATION

LAND CORNER RECORDATION CERTIFICATE
Filing Requirement of Act 74, Mich. P.A. 1970

STATE OF MICHIGAN
COUNTY OF BARRY
RECEIVED FOR RECORD

AUG 20 11 27 AM '96

Sandy Schondelmayer
REGISTER OF DEEDS

002398

Register of Deeds Stamp & File Number

For corners in

BARRY
(County)

Located In:

Corner Code: #

- 1. Public Land Survey T 3N R9W Corner Code: K-1
- CORNER COMMON TO SECTIONS T _____ R _____
- 1 & 2 RUTLAND TOWNSHIP T _____ R _____
- ON TOWNSHIP LINE T _____ R _____
- 2. Property Controlling S _____ T _____ R _____
- in Section S _____ T _____ R _____
- 3. Miscellaneous S _____ T _____ R _____
- Property in Sec. S _____ T _____ R _____
- 4. Lot No. _____, Recorded Plat _____
- 5. Private Claims _____

	A	B	C	D	E	F	G	H	I	J	K	L	M
2	6		5		4		3		2		1		
3													
4	7		8		9		10		11		12		
5													
6	18		17		16		15		14		13		
7													
8	19		20		21		22		23		24		
9													
10	30		29		28		27		26		25		
11													
12	31		32		33		34		35		36		
13													

I, BRIAN REYNOLDS in a field survey on 31 MARCH 1995
do hereby certify that under requirements of P.A. 74, Michigan P.A. of 1970, the corner points mentioned in lines 1 and 2 above were in conformance with regulations and rules therefore as required in the current manual of survey instructions of the United States Department of the Interior, Bureau of Land Management or by a decree of a Court of Law and/or that the corner points mentioned in lines 3, 4 and 5 above were in conformance with the rules of the Michigan Board of Land Surveyors or by a Decree of a Court of Law; established, re-established, monumented, re-monumented, recovered, found as expressed below:

NOTE: Not more than 4 corners, all in the same town and range, may be recorded on this certificate.

A. Description of original monument and accessories and/or subsequent restoration

GENERAL LAND OFFICE: SYLVESTER SIBLEY, D.S., 1831 (R9W,P.121)
"NORTH 82.25 INTERSECTED N. BOUNDARY 36 WEST OF POST"
A W. OAK 20 S69E 31 Do. 16 S54W 64
LAND CORNER RECORDATION CERTIFICATE: #364 BY PAUL E. VAN KOOTEN, P.S.#8618
NO EVIDENCE OF CORNER FOUND, SET 3/4" IRON PIPE ON CENTERLINE OF WOODRUFF AND ON FENCE LINE TO SOUTH"
SQ. SPIKE IN E SIDE 48" OAK S 36.78' SQ. SPIKE IN S'LY SIDE 30" OAK E-NE 117.46'
SQ. SPIKE IN NW SIDE 44" OAK NE 36.10' OLD FENCE TO N ON TREE ROW E 19'+/-
ACT 132 SURVEY (L.1, P.774) P.E. VAN KOOTEN P.S.#8618 WITNESSES SAME AS IN LCRC #364 ABOVE


B. Description of corner evidence found and/or method applied in restoring or reestablishing corner

FOUND 3/4" PIPE. FOUND SQUARE SPIKE IN AN OAK NORTHEAST AND A BLAZE IN BOTH THE OAK EAST-NORTHEAST AND THE OAK SOUTH. ALL WITNESSES CONFORM WITH DISTANCES BY VANKOOTEN AS IN L.C.R.C. #364 ABOVE.
ACCEPTED FOUND 3/4" PIPE BY VANKOOTEN AS BEST EVIDENCE OF CORNER POSITION.
REPLACED 3/4" PIPE WITH STANDARD BARRY COUNTY REMONUMENTATION MONUMENT.

ACT 345 BARRY COUNTY REMONUMENTATION
APPROVED BY PEER REVIEW AT A MEETING HELD ON
APRIL 10, 1995 BR
BRIAN REYNOLDS COUNTY SURVEYOR

C. Description of monument for corner and accessories established to perpetuate locating the position of the corner:

SET STANDARD BARRY COUNTY REMONUMENTATION MONUMENT (3/4"X36"W/ALUMINUM CAP)
SET 40d NAIL W/PLASTIC TAG IN THE EAST SIDE OF A 60" OAK S8°E 36.98'
FOUND SPIKE IN THE WEST SIDE OF A 72" OAK N36°E 36.09'
SET 40d NAIL W/PLASTIC TAG IN THE WEST SIDE OF AN 8" OAK N9°E 55.96'
SET 40d NAIL W/PLASTIC TAG IN THE EAST SIDE OF A 6" OAK N45°W 43.55'
SET 40d NAIL W/PLASTIC TAG IN THE NORTH SIDE OF A 36" OAK N77°E 117.31'
K-13 T4N, R9W, IRVING TOWNSHIP EAST 23.76'

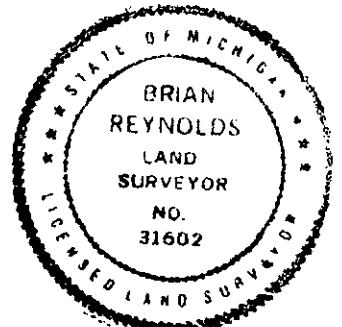

Signed by [Signature]
Surveyor's Michigan License No. 31602

Date AUGUST 16, 1996