

SURVEY & REMONUMENTATION

1993

COMMISSION

For corners in

BARRY

(County)

**BARRY COUNTY REMONUMENTATION
LAND CORNER RECORDATION CERTIFICATE
Filing Requirement of Act 74, Mich. P.A. 1970**

Located In: Corner Code #

STATE OF MICHIGAN
COUNTY OF BARRY
RECEIVED FOR RECORD

JUL 20 11 20 AM '93

Sandy Schondelmaier
REGISTER OF DEEDS

002055

Register of Deeds Stamp & File Number

- 1. Public Land Survey T 3N R 9W K-9
T _____ R RUTLAND TWNSP.
T _____ (COR. SEC. 23, 24, 25, & 26)
T _____ R _____
- 2. Property Controlling S _____ T _____ R _____
in Section S _____ T _____ R _____
- 3. Miscellaneous S _____ T _____ R _____
Property in Sec. S _____ T _____ R _____

- 4. Lot No. _____, Recorded Plat _____
- 5. Private Claims _____

	A	B	C	D	E	F	G	H	I	J	K	L	N
2	6		5		4		3		2		1		
3													
4	7		8		9		10		11		12		
5													
6	18		17		16		15		14		13		
7													
8	19		20		21		22		23		24		
9													
10	30		29		28		27		26		25		
11													
12	31		32		33		34		35		36		
13													

BRIAN REYNOLDS

JUN

93


I, _____, in a field survey on _____, 19_____, do hereby certify that under requirements of P.A. 74, Michigan P.A. of 1970, the corner points mentioned in lines 1 and 2 above were in conformance with regulations and rules therefore as required in the current manual of survey instructions of the United States Department of the Interior, Bureau of Land Management or by a decree of a Court of Law and/or that the corner points mentioned in lines 3, 4 and 5 above were in conformance with the rules of the Michigan Board of Land Surveyors or by a Decree of a Court of Law; established, re-established, monumented, re-monumented, recovered, found as expressed below:

NOTE: Not more than 4 corners, all in the same town and range, may be recorded on this certificate.

A. Description of original monument and accessories and/or subsequent restoration:
G.L.O. : LEE COBB (BOOK IX)(MARCH 28 & 29, 1892):
BEECH 8 N60W 10 FOUND BOTH STUMPS OF U.S. TREE &
BEECH 7 S86E 34 TILE FOR STAKE.

B. Description of corner evidence found and/or method applied in restoring or reestablishing corner:
FOUND 1/2" IRON IN 3" DIA. CLAY TILE:
EAST - WEST FENCE +/-1' N.
FENCE NORTH, +/-4' E.
FENCE SOUTH, +/-2' E.

C. Description of monument for corner and accessories established to perpetuate locating the position of the corner:
SET BARRY Co. REMON. MONUMENT, SURROUNDED WITH STONES:
N. FACE - 14" MAPLE - N42E - 38.76'
S. FACE - 30" OAK - EAST - 7.95
E. FACE - 5" OAK - S32W - 16.83'
E. FACE - 5" OAK - S64W - 28.90'
NE. FACE - 10" ASH - N45W - 28.96'
(40 D NAIL WITH SHINER FOR WITNESS)

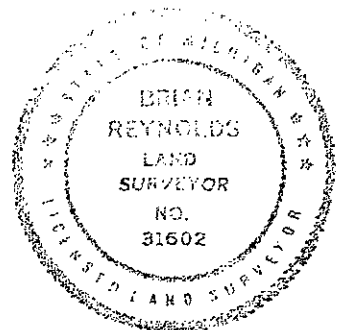

Signed by *Brian Reynolds*

Date 7-13-1993

Surveyor's Michigan License No. 31602