

**SURVEY &
REMONUMENTATION**

APR 26 1995

COMMISSION

**BARRY COUNTY REMONUMENTATION
LAND CORNER RECORDATION CERTIFICATE**
Filing Requirement of Act 74, Mich. P.A. 1970

STATE OF MICHIGAN
COUNTY OF BARRY
RECEIVED FOR RECORD

Nov 22 3 43 PM '94

Sandy Schmalzmaier
REGISTER OF DEEDS

002241

Register of Deeds Stamp & File Number

corners in _____
Barry (County) Located In: Rutland Township Corner Code #/

Public Land Survey	T <u>3N</u> R <u>9W</u>	<u>K-10</u>
	T _____ R _____	<u>W 1/4 Corner</u>
	T _____ R _____	<u>Section 25</u>
	T _____ R _____	_____
Property Controlling in Section	S _____ T _____ R _____	_____
	S _____ T _____ R _____	_____
Miscellaneous Property in Sec.	S _____ T _____ R _____	_____
	S _____ T _____ R _____	_____

Lot No. _____, Recorded Plat _____
Private Claims _____

Chris Marschall, in a field survey on August 8, 19 94,
hereby certify that under requirements of P.A. 74, Michigan P.A. of 1970, the corner points mentioned in lines 1 and 2 above were in conformance with regulations and rules therefore as required in the current manual of survey instructions of the United States Department of the Interior, Bureau of Land Management or by a decree of a Court of Law and/or that the corner points mentioned in lines 3, 4 and 5 above were in conformance with the rules of the Michigan Board of Land Surveyors or by a Decree of a Court of Law; established, re-established, monumented, re-monumented, recovered, found as expressed below:

NOTE: Not more than 4 corners, all in the same town and range, may be recorded on this certificate.

A	B	C	D	E	F	G	H	I	J	K	L	M
2	6	5	4	3	2	1						
3												
4	7	8	9	10	11	12						
5												
6	18	17	16	15	14	13						
7												
8	19	20	21	22	23	24						
9												
10	30	29	28	27	26	25						
11												
12	31	32	33	34	35	36						
13												

Description of original monument and accessories and/or subsequent restoration:

GL0 Set cor @ 40 ch Beech 15 S17°W 13'
W Ash 4" S78°E 30'
STake and Stones
Brick added later(1890)


Description of corner evidence found and/or method applied in restoring or reestablishing corner:

Found Nothing - Fill Section of Roadway
Set Standard Barry County Monument midway and on line between NW and SW corner of Section 25

ACT 345 BARRY COUNTY REMONUMENTATION
APPROVED BY PEER REVIEW AT A MEETING HELD ON
7 June '94
BRIAN REYNOLDS COUNTY SURVEYOR

Description of monument for corner and accessories established to perpetuate locating the position of the corner:

K-10 Standard Barry County Monument (3/4 Iron) with aluminum cap
Nail and Tag in E side 16" Bitter Hickory S6°40'E 40.57'
Nail and Tag in E side 6" Maple S22°E 60.07'
Nail and Tag in E side 6" Oak S17°30'W 32.12'
Nail and Tag in SE side 14" Cherry (5' High) S48°30'W 43.88'
on Center line of E-W Gravel Road
East Edge of swamp on North side of Road East 90'±

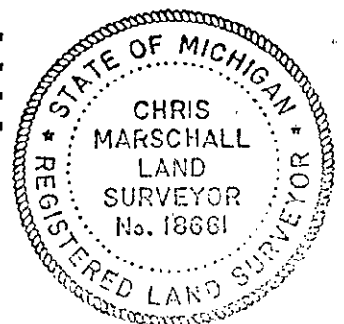

Signed by Chris Marschall Date August 8, 1994
Surveyor's Michigan License No. 18661