

SURVEY & REMONUMENTATION

JUL 24 1997

COMMISSION

BARRY COUNTY REMONUMENTATION

LAND CORNER RECORDATION CERTIFICATE
Filing Requirement of Act 74, Mich. P.A. 1970

002497

STATE OF MICHIGAN
BARRY COUNTY
RECORDED

17 JUN 97 12:19 P.M.

SANDY SCHONDELMAYER
REGISTER OF DEEDS

For Corners in <u>BARRY</u> (county)	Located In:	Corner Code #
1. Public Land Survey CORNER COMMON TO SECTIONS 35 & 36 RUTLAND TOWNSHIP ON TOWNSHIP LINE	T <u>3N</u> R <u>9W</u>	<u>K-13</u>
2. Property Controlling in Section	S ___ T ___ R ___ S ___ T ___ R ___	___
3. Miscellaneous Property in Sec.	S ___ T ___ R ___ S ___ T ___ R ___	___
4. Lot No _____, Recorded Plat _____		
5. Private Claims _____		

Register of Deeds Stamp & File Number

I, **Brian Reynolds**, in a field survey on **17 NOVEMBER, 1996** do hereby certify that under requirements of P.A. 74, Michigan P.A. of 1970, the corner points mentioned in lines 1 and 2 above were in conformance with regulations and rules therefore as required in the current manual of survey instructions of the United States Department of the Interior, Bureau of Land Management or by a decree of a Court of Law and/or that the corner points mentioned in lines 3, 4, and 5 above were in conformance with the rules of the Michigan Board of Land Surveyors or by a Decree of a Court of Law; established, re-established, monumented, re-monumented, recovered, found as expressed below.

NOTE: Not more than 2 corners, all in the same town and range, may be recorded on this certificate.

	A	B	C	D	E	F	G	H	I	J	K	L	M
2	6		5		4		3		2		1		
3													
4	7		8		9		10		11		12		
5													
6	18		17		16		15		14		13		
7													
8	19		20		21		22		23		24		
9													
10	30		29		28		27		26		25		
11													
12	31		32		33		34		35		36		
13													

A. Description of original monument and accessories and/or subsequent restoration:

- 1 GENERAL LAND OFFICE: JOHN MULLETT, D.S., 1826 (R9W,P.106)
TAMK 9 N38E 67 Do. 7 N44W 72
- 2 COUNTY SURVEYOR RECORDS: A.D. RORK, FEB. 26, 1866 (L.2, P.72) "BEARINGS FOUND"

***** NO OTHER RECORDED HISTORICAL INFORMATION AVAILABLE FOR THIS CORNER *****

B. Description of corner evidence found and/or method applied in restoring or reestablishing corner:


FOUND NO EVIDENCE OF CORNER MONUMENTATION. TRAVERSED OF ALL OF SECTION 36, TYING IN EXTENSIVE AMOUNTS OF OLD OCCUPATION FENCE THROUGHOUT ENTIRE SECTION. SET CORNER AT THE INTERSECTION OF OLD OCCUPATION FENCE LINES RUNNING NORTH, EAST, AND WEST. CORNER LIES IN THE EAST EDGE OF A SMALL HUMMOCK/ROOT SYSTEM SURROUNDED BY 2'-3' OF OPEN WATER IN LARGE SWAMP. FENCE TO THE EAST IS DOWN CLOSE TO CORNER, BUT IS STANDING 150'+/- EAST OF CORNER FENCE NORTH AND WEST IS DOWN CLOSE TO CORNER, BUT CAN BE FOUND WITH IRON FINDER. SET 3/4" x 5' LONG GALVANIZED PIPE WITH REMONUMENTATION CAP.

C. Description of monument for corner and accessories established to perpetuate locating the position of the corner:

- SET 3/4" x 5' LONG GALVANIZED PIPE WITH REMONUMENTATION CAP
- NO TIMBER NEAR CORNER
- K-12 LIES N01°00'46"E 2619.63'
- L-13 LIES S89°09'10"E 2647.53'
- 60d NAIL (TRAVERSE POINT) LIES N08°13'05"E 374.93'
- 60d NAIL (TRAVERSE POINT) LIES N76°29'19"E 349.37'
- 60d NAIL (TRAVERSE POINT) LIES S88°10'34"E 708.26'

ACT 345 BARRY COUNTY REMONUMENTATION
APPROVED BY PEER REVIEW AT A MEETING HELD ON

11-13-95 BR
BRIAN REYNOLDS COUNTY SURVEYOR

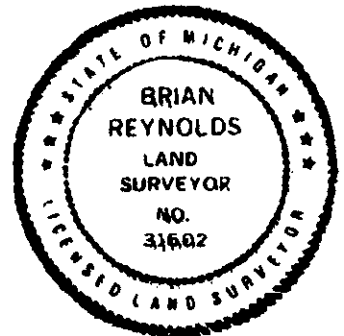

Signed by [Signature]
Surveyor's Michigan License No 31602

Date MAY 16, 1997