

SURVEY & REMONUMENTATION

APR 26 1995

COMMISSION

BARRY COUNTY REMONUMENTATION LAND CORNER RECORDATION CERTIFICATE

Filing Requirement of Act 74, Mich. P.A. 1970

STATE OF MICHIGAN
COUNTY OF BARRY
REGISTER OF DEEDS

Nov 22 3 43 PM '94

Sandy Schrock-Schaefer
REGISTER OF DEEDS

002244

Register of Deeds Stamp & File Number

corners in	Located In:	Corner Code //
Barry (County)	Rutland Township	
Public Land Survey	T <u>3N</u> R <u>9W</u>	L-11
	T _____ R _____	S 1/4 Corner
	T _____ R _____	Section 25
	T _____ R _____	
Property Controlling in Section	S _____ T _____ R _____	
Miscellaneous	S _____ T _____ R _____	
Property in Sec.	S _____ T _____ R _____	

Lot No. _____, Recorded Plat _____
Private Claims _____

	A	B	C	D	E	F	G	H	I	J	K	L	M
2	6	5	4	3	2	1							
3													
4	7	8	9	10	11	12							
5													
6	18	17	16	15	14	13							
7													
8	19	20	21	22	23	24							
9													
10	30	29	28	27	26	25							
11													
12	31	32	33	34	35	36							
13													

Chris Marschall, in a field survey on August 8, 1994, hereby certify that under requirements of P.A. 74, Michigan P.A. of 1970, the corner points mentioned in lines 1 and 2 above were in conformance with regulations and rules therefore as required in the current manual of survey instructions of the United States Department of the Interior, Bureau of Land Management or by a decree of a Court of Law and/or that the corner points mentioned in lines 3, 4 and 5 above were in conformance with the rules of the Michigan Board of Land Surveyors or by a Decree of a Court of Law; established, re-established, monumented, re-monumented, recovered, found as expressed below:

NOTE: Not more than 4 corners, all in the same town and range, may be recorded on this certificate.

Description of original monument and accessories and/or subsequent restoration:

- GLO in Pond 40.20 Ch (2653.2)
- (5306.4)
- South Line measures 5315.64 (1890)
- 5319.6 (1900)

Description of corner evidence found and/or method applied in restoring or reestablishing corner:


Established corner midway and on line between the SE and the SW corners of Section 25.

ACT 345 BARRY COUNTY REMONUMENTATION
APPROVED BY PEER REVIEW AT A MEETING HELD ON
7 June '94
BRIAN REYNOLDS COUNTY SURVEYOR

Description of monument for corner and accessories established to perpetuate locating the position of the corner:

- Corner in Lake & not set
- SW corner (Monument) N89°09'03"W 2656.56'
- SE corner (Monument) S89°09'03"E 2656.56'
- Reference Monument S89°09'03"E 479.89'
- Reference Monument N89°09'03"W 1483.84'
- Reference Monument on 1/4 line N00°34'27"W 919.12'

SEE OTHER SIDE FOR REFERENCE MONUMENT WITNESSES

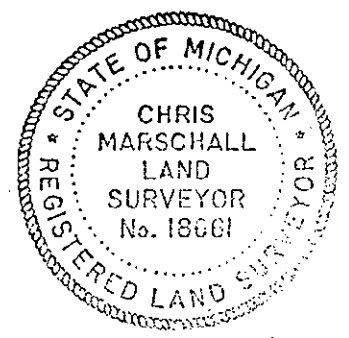

Drawn by Chris Marschall Date August 8, 1994
Surveyor's Michigan License No. 18661

"A" Standard Barry County Monument (3/4" Iron) with aluminum cap		
Nail and Tag in SE side 10" Walnut	N40°E	6.87'
North Corner of North Sign Post	N25°E	19.21'
Center of West end CMP	West	18.87'
Center of Gravel Road	NW	33.0'
SW Corner of Section 25	S89°09'03"E	1172.72'
S 1/4 Corner (in lake and not set)	N89°09'03"W	1483.84'

"B" Standard Barry County Monument (3/4" Iron) with Aluminum Cap		
Nail and Tag in N side of 18" Butternut	N80°E	46.57'
Nail and Tag in E side of 6" Maple	N20°W	59.18'
Nail and Tag in NE side of 32" Oak	N50°W	30.07'
Nail and Tag in S side of 42" Oak	N80°W	48.33'
South 1/4 Corner (in lake and not set)	S00°34'27"E	919.12'
Center of Section	N00°34'27"W	1715.01'

"C" Standard Barry County Monument (3/4" Iron) with aluminum cap		
Nail and Tag in W side Twin 20" Oak	N5°E	9.78'
Nail and Tag in E side 36" Oak	N10°W	15.35'
Nail and Tag in E side 18" Oak	N25°W	10.55'
Nail and Tag in N side 10" Cherry (7' High)	West	14.53'
East Margin of Lake	West	20'±
Top of Bank	East	5'±
Center of Gravel Road	Northeast	100'±
South 1/4 Corner (in lake and not set)	N89°09'03"W	479.89'
SE Corner	S89°09'03"E	2176.67'

