

APR 08 1996

BARRY COUNTY REMONUMENTATION

STATE OF MICHIGAN  
COUNTY OF BARRY  
RECEIVED FOR RECORD

COMMISSION

LAND CORNER RECORDATION CERTIFICATE  
Filing Requirement of Act 74, Mich. P.A. 1970

DEC 15 3 07 PM '95

Sandy Schondelmar  
REGISTER OF DEEDS

For corners in

**BARRY**  
(County)

Located In:

Corner Code #

1. Public Land Survey  
CENTER OF SECTION 36  
RUTLAND TOWNSHIP

T	<u>3N</u>	R	<u>9W</u>	<u>L-12</u>
T	_____	R	_____	_____
T	_____	R	_____	_____
T	_____	R	_____	_____
S	_____	T	_____	_____
S	_____	T	_____	_____
S	_____	T	_____	_____
S	_____	T	_____	_____

2. Property Controlling  
in Section  
3. Miscellaneous  
Property in Sec.

4. Lot No. \_\_\_\_\_, Recorded Plat \_\_\_\_\_  
5. Private Claims \_\_\_\_\_

002371

Register of Deeds Stamp & File Number

A	B	C	D	E	F	G	H	I	J	K	L	M
2	6	5	4	3	2	1						
3												
4	7	8	9	10	11	12						
5												
6	18	17	16	15	14	13						
7												
8	19	20	21	22	23	24						
9												
10	30	29	28	27	26	25						
11												
12	31	32	33	34	35							
13												

I, **BRIAN REYNOLDS**, in a field survey on **1 NOVEMBER**, 19 **95**

do hereby certify that under requirements of P.A. 74, Michigan P.A. of 1970, the corner points mentioned in lines 1 and 2 above were in conformance with regulations and rules therefore as required in the current manual of survey instructions of the United States Department of the Interior, Bureau of Land Management or by a decree of a Court of Law and/or that the corner points mentioned in lines 3, 4 and 5 above were in conformance with the rules of the Michigan Board of Land Surveyors or by a Decree of a Court of Law; established, re-established, monumented, re-monumented, recovered, found as expressed below:


**NOTE: Not more than 4 corners, all in the same town and range, may be recorded on this certificate.**

A. Description of original monument and accessories and/or subsequent restoration:

**1 CORNER NOT SET BY THE GENERAL LAND OFFICE**

**2 COUNTY SURVEYOR RECORDS: BOWEN, 27-28 FEB., 1877 (L.1, P.187) "SET AT INT. 1/4 LINES"  
HICKORY 5 S74 1/2E 78 W. OAK 7 N68 1/2W 2.16**

**NO OTHER RECORDED HISTORICAL INFORMATION AVAILABLE FOR THIS CORNER.**

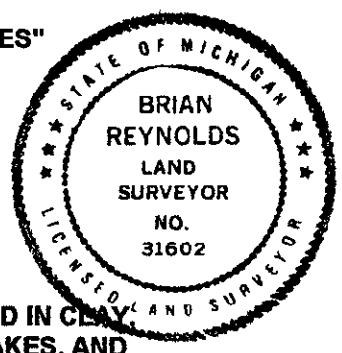

B. Description of corner evidence found and/or method applied in restoring or reestablishing corner:

**FOUND A VERY OLD 1/2" X 1" X 24" SOLID IRON STRAP BURIED 6" UNDER GRAVEL IMBEDDED IN CLAY. AFTER TRAVERSE OF ENTIRE SECTION 36, AND RESTORATION OF ALL CORNERS NOT IN LAKES, AND TYING IN OCCUPATION CORNERS AT ALL 40 AND 80 ACRE PARCELS, ACCEPTED FOUND IRON STRAP AS BEING CONSISTENT WITH MEASUREMENTS BY BOWEN, 1877. ACCEPTED AS BEST EVIDENCE OF CORNER POSITION BY BOWEN.**

ACT 345 BARRY COUNTY REMONUMENTATION  
APPROVED BY PEER REVIEW AT A MEETING HELD ON

11/13/95 BR  
BRIAN REYNOLDS COUNTY SURVEYOR

C. Description of monument for corner and accessories established to perpetuate locating the position of the corner:

**SET STANDARD BARRY COUNTY REMONUMENTATION MONUMENT (WITH ALUMINUM CAP)  
TOP CENTER OF A 2" SOLID ROUND IRON FENCE CORNER POST N4°E 22.12'  
SET 20d NAIL WITH REMON TAG IN THE WEST SIDE OF A 12" TWIN HICKORY N34°E 31.79'  
SET 20d NAIL WITH REMON TAG IN THE SOUTHEAST SIDE OF A 10" TWIN HICKORY N51°E 42.47'  
SET 20d NAIL WITH REMON TAG IN THE NORTHEAST SIDE OF A 28" BLACK WALNUT N70°W 74.78'  
SET 20d NAIL WITH REMON TAG IN THE SOUTH SIDE OF A UTILITY POLE S78°E 141.76'  
1/2" IRON WITH PLASTIC CAP S00°58'58"W 33.00'  
CENTERLINE OF EAST-WEST GRAVEL ROAD (TANNER LAKE ROAD) NORTH 2'+/-**

Signed by [Signature]

Date 12/15/95

Surveyor's Michigan License No. 31602