

**SURVEY & REMONUMENTATION**

APR 26 1995

**COMMISSION**

**Barry County Remonumentation  
LAND CORNER RECORDATION CERTIFICATE  
Filing Requirement of Act 74, Mich. P.A. 1970**

STATE OF MICHIGAN  
COUNTY OF BARRY  
RECEIVED FOR RECORD

DEC 8 8 15 AM '94


Sandy Schindelmarer  
REGISTER OF DEEDS

002249

Register of Deeds Stamp & File Number

For corners in Barry (County)  
Public Land Survey Located In: Corner Code #/ #  
T 3N R 9W M-1 (NE, 1)  
T R Rutland Twp.  
T 4N R 9W M-13 (SE, 36)  
T R Irving Twp.  
Property Controlling in Section S T 4N R 8W A-13 (SW, 31)  
S T R Carlton Twp.  
Miscellaneous Property in Sec. S T 3N R 8W A-1 (NW, 6)  
S T R Hasting Twp.

T3N R2W HASTINGS T3N R3W RUTLAND

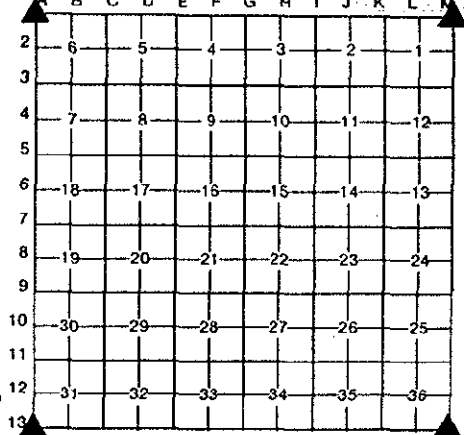

John C. Bueche, in a field survey on September 19 94, hereby certify that under requirements of P.A. 74, Michigan P.A. of 1970, the corner points mentioned in lines 1 and 2 above were in conformance with regulations and rules therefore as required in the current manual of survey instructions of the United States Department of the Interior, Bureau of Land Management or by a decree of a Court of Law and/or that the corner points mentioned in lines 3, 4 and 5 above were in conformance with the rules of the Michigan Board of Land Surveyors or by a Decree of a Court of Law; established, re-established, monumented, re-monumented, recovered, found as expressed below:

NOTE: Not more than 4 corners, all in the same town and range, may be recorded on this certificate.

Description of original monument and accessories and/or subsequent restoration:  
M-1 GLO LCRC #413, 7-90, RR spk.  
Post 30" Oak N 05° W 21.48'  
W. Oak 18" S 35 lks. 10" Cherry N 70° W 69.34'  
W. Oak 11" N 53° E 6 lks. C/L Rd. 3'± S  
L. Lyons, D.S., 1826 In line fence N

Description of corner evidence found and/or method applied in restoring or reestablishing corner:  
M-1 Found RR spk., on top of stone (4" top, 8" bottom, 15" high) As per above wit.

Accepted as a careful and faithful perpetuation of the position of the original corner.

ACT 345 BARRY COUNTY REMONUMENTATION  
APPROVED BY PEER REVIEW AT A MEETING HELD ON  
4 Oct 94  
BRIAN REYNOLDS COUNTY SURVEYOR

Description of monument for corner and accessories established to perpetuate locating the position of the corner:  
M-1 Replaced stone & RR spk. with Barry Co. Mon. (3/4" x 24" Pin with Alum. Cap)  
Nail & Barry Co. Remon. Tag in S side 10" Maple N 75° W 97.40'  
Nail & Barry Co. Remon. Tag in SW side 6" Maple N 55° W 59.60'  
Nail & Barry Co. Remon. Tag in SW side 10" W. Cherry N 50° W 49.97'  
40d Nail & RLS Cap #31602 in W side 36" Oak N 5° W 21.48'  
C/L gravel E-W, N 3'±, on old fence line North

Signed by John C. Bueche  
Surveyor's Michigan License No. 13027

Date 10-26-94

