

SURVEY & REMONUMENTATION

APR 26 1995

COMMISSION

BARRY COUNTY REMONUMENTATION LAND CORNER RECORDATION CERTIFICATE Filing Requirement of Act 74, Mich. P.A. 1970

STATE OF MICHIGAN
COUNTY OF BARRY
REGISTER OF DEEDS

NOV 22 3 43 PM '94

Sandy Schuchtmeyer
REGISTER OF DEEDS

002245

Register of Deeds Stamp & File Number

Corner in	Barry (County)	Located In: Rutland Township	Corner Code #
Public Land Survey	T 3N R 9W	M-11	SE corner
	T R	Section 25	
	T R		
	T R		
Property Controlling in Section	S T R		
Miscellaneous Property in Sec.	S T R		

Lot No. _____, Recorded Plat _____
Private Claims _____

	A	B	C	D	E	F	G	H	I	J	K	L	M
2	6	5	4	3	2	1							
3													
4	7	8	9	10	11	12							
5													
6	18	17	16	15	14	13							
7													
8	19	20	21	22	23	24							
9													
10	30	29	28	27	26	25							
11													
12	31	32	33	34	35	36							
13													

Chris Marschall, in a field survey on August 8, 1994, hereby certify that under requirements of P.A. 74, Michigan P.A. of 1970, the corner points mentioned in lines 1 and 2 above were in conformance with regulations and rules therefore as required in the present manual of survey instructions of the United States Department of the Interior, Bureau of Land Management or by a decree of a Court of Law and/or that the corner points mentioned in lines 3, 4 and 5 above were in conformance with the rules of the Michigan Board of Land Surveyors or by a Decree of a Court of Law; established, re-established, monumented, re-monumented, recovered, found as expressed below:

NOTE: Not more than 4 corners, all in the same town and range, may be recorded on this certificate.

Description of original monument and accessories and/or subsequent restoration:

- GLO R Oak 30 N35W 91
- Ash 12 S27½ W 128
- Co Surveyor W Oak 8 N18½W 102 (No Date)
- W Oak 10 S5½E 49
- Fd Old Stake Oak S5E 49
- W Oak N60E 45
- Found 1890


Description of corner evidence found and/or method applied in restoring or reestablishing corner:

- Found 1/2" Iron & Held as best evidence of true corner location
- Set Standard Barry County Monument

ACT 345 BARRY COUNTY REMONUMENTATION
APPROVED BY PEER REVIEW AT A MEETING HELD ON
7 June 1994
BRIAN REYNOLDS COUNTY SURVEYOR

Description of monument for corner and accessories established to perpetuate locating the position of the corner:

- M-11 Standard Barry County Monument (3/4 Iron) with aluminum cap
- Nail and Tag in S side 22" Hickory S75°30"E 14.10'
- Nail and Tag in SE side 28" Oak N41°30"E 67.58'
- Nail and Tag in W side 28" Butternut N13°E 75.75'
- Nail and Tag in N side PP S83°30'W 115.04'
- NE corner Garage to Hse #1010 Quimby (Siding) S69°30'W 141.36'

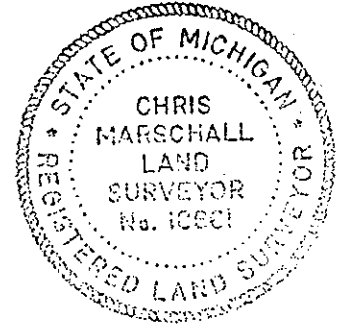

Surveyed by Chris Marschall Date August 8, 1994
Surveyor's Michigan License No. 18661