

APR 08 1996

BARRY COUNTY REMONUMENTATION

STATE OF MICHIGAN  
COUNTY OF BARRY  
RECEIVED FOR RECORD

COMMISSION

LAND CORNER RECORDATION CERTIFICATE  
Filing Requirement of Act 74, Mich. P.A. 1970

DEC 15 3 07 PM '95

Sandy Schondalmar  
REGISTER OF DEEDS

For corners in  
**BARRY**  
(County)


Located In: Corner Code #

1. Public Land Survey  
E 1/4 CORNER SECTION  
36 RUTLAND TOWNSHIP  
ON RANGE LINE

T 3N R 9W M-12  
T R  
T R

2. Property Controlling  
in Section  
3. Miscellaneous  
Property in Sec.

S T  
S T  
S T  
S T

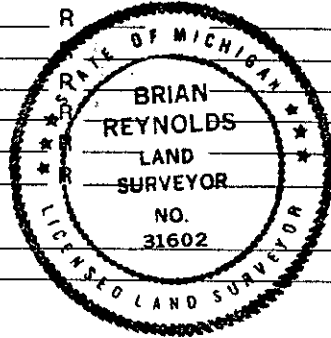

4. Lot No. \_\_\_\_\_, Recorded Plat  
5. Private Claims \_\_\_\_\_

Register of Deeds Stamp & File Number

002372

**BRIAN REYNOLDS**

**1 NOVEMBER**

**95**

I, BRIAN REYNOLDS, in a field survey on 1 NOVEMBER, 1995  
do hereby certify that under requirements of P.A. 74, Michigan P.A. of 1970, the corner points mentioned  
in lines 1 and 2 above were in conformance with regulations and rules therefore as required in the  
current manual of survey instructions of the United States Department of the Interior, Bureau of Land  
Management or by a decree of a Court of Law and/or that the corner points mentioned in lines 3, 4 and 5  
above were in conformance with the rules of the Michigan Board of Land Surveyors or by a Decree of a  
Court of Law; established, re-established, monumented, re-monumented, recovered, found as  
expressed below:

	A	B	C	D	E	F	G	H	I	J	K	L	M
2	6		5		4		3		2		1		
3													
4	7		8		9		10		11		12		
5													
6	18		17		16		15		14		13		
7													
8	19		20		21		22		23		24		
9													
10	30		29		28		27		26		25		
11													
12	31		32		33		34		35		36		
13													

**NOTE: Not more than 4 corners, all in the same town and range, may be recorded on this certificate.**

A. Description of original monument and accessories and/or subsequent restoration:

GENERAL LAND OFFICE: L. LYON, D.S., 1826 (R9W,P.108) MAPLE 22 S76W 50 BEECH 7 N31W 59  
COUNTY SURVEYOR RECORDS: NO NAME (TAN BARRY TWP. F.B.,P.23) BEECH 20 S77W 50 BEECH 16 N57W 39  
ALSO: BOWEN, 27-28 FEB, 1877(L.1,P.187) "FOUND REMAINS OF OLD BEARINGS, NEW ONES" BEECH 30 N88 1/2E 13  
W.WOOD 20 N35E 76

**NO OTHER RECORDED HISTORICAL INFORMATION AVAILABLE FOR THIS CORNER**

B. Description of corner evidence found and/or method applied in restoring or reestablishing corner:

**CORNER POSITION LIES IN AN 8 - 10 FOOT CUT AREA. ANY EVIDENCE OF CORNER MONUMENTATION HAS LONG BEEN DESTROYED. COUNTY SURVEYOR LEE S. COBB APPARENTLY DID NOT FOND THIS CORNER WHEN HE RESTORED A11 T-3-N, R-8-W, HASTINGS TOWNSHIP, IN 1889 AND AGAIN IN 1895 (LEE COBB BOOK IX, PP.47-48).**

**RESTORED M-12 ON LINE AND AT AN EVEN SPLIT BETWEEN M-11 AND RESTORED M-13.**

ACT 345 BARRY COUNTY REMONUMENTATION  
APPROVED BY PEER REVIEW AT A MEETING HELD ON  
11/13/95 BR  
BRIAN REYNOLDS COUNTY SURVEYOR

C. Description of monument for corner and accessories established to perpetuate locating the position of the corner:

**SET STANDARD BARRY COUNTY REMONUMENTATION MONUMENT (WITH ALUMINUM CAP)  
SET 20d NAIL WITH REMON TAG IN THE TOP CENTER OF A WOODEN CORNER POST S64°W 45.32'  
SET 20d NAIL WITH REMON TAG IN THE NORTH SIDE OF AN 18" TWIN BLACK WALNUT S86°W 103.35'  
SET 20d NAIL WITH REMON TAG IN THE SOUTH SIDE OF A 28" OAK N77°W 124.34'  
SET 20d NAIL WITH REMON TAG IN THE EAST SIDE OF A 36" BLACK WALNUT N21°W 74.70'  
SET 20d NAIL WITH REMON TAG IN THE WEST SIDE OF A 24" BLACK WALNUT S18°E 28.81'  
CENTERLINE OF A NORTH-SOUTH GRAVEL ROAD (COOK ROAD) IS WEST 11'+/-  
CENTERLINE OF A GRAVEL ROAD WEST (TANNER LAKE ROAD) AND A FENCE LINE EAST IS NORTH 10.5'+/-  
A-12 T-3-N, R-8-W, HASTINGS TOWNSHIP LIES N01°12'46"E 9.59'**

Signed by [Signature] Date 12/15/95  
Surveyor's Michigan License No. 31602