

LAND CORNER RECORDATION CERTIFICATE
Filing Requirement of Act 74, Mich. P.A. 1970

For corners in
Barry
 (County)

Located In: _____ Corner Code **J5**

- | | | | | | |
|------------------------------------|---|----|---|-----|----|
| 1. Public Land Survey | T | 3N | R | 10W | J5 |
| | T | | R | | |
| | T | | R | | |
| | T | | R | | |
| 2. Property Controlling in Section | S | | T | R | |
| | S | | T | R | |
| 3. Miscellaneous Property in Sec. | S | | T | R | |
| | S | | T | R | |

Register of Deeds Stamp & File Number

4. Lot No. _____, Recorded Plat _____
 5. Private Claims _____

I, **Gary C. Bilow**, in a field survey on **April 01, 1993**, 19____ do hereby certify that under requirements of P.A. 74, Michigan P.A. of 1970, the corner points mentioned in lines 1 and 2 above were in conformance with regulations and rules therefore as required in the current manual of survey instructions of the United States Department of the Interior, Bureau of Land Management or by a decree of a Court of Law and/or that the corner points mentioned in lines 3, 4 and 5 above were in conformance with the rules of the Michigan Board of Land Surveyors or by a Decree of a Court of Law; established, re-established, monumented, re-monumented, recovered, found as expressed below:

NOTE: Not more than 4 corners, all in the same town and range, may be recorded on this certificate.

	A	B	C	D	E	F	G	H	I	J	K	L	M
2	6		5		4		3		2		1		
3													
4	7		8		9		10		11		12		
5										●			
6	18		17		16		15		14		13		
7													
8	19		20		21		22		23		24		
9													
10	30		29		28		27		26		25		
11													
12	31		32		33		34		35		36		
13													

A. Description of original monument and accessories and/or subsequent restoration:


J5: Post established by U. S. Deputy Surveyor S. Sibley in 1831 - accessories: W. Oak 8 SE 26 links & double W. Oak 20 N14W 112 links. Records obtained of Raymond E. Moored (PS #26463) from Tri-County Land Survey, P.C., dated 1/2/86, state "Set 1/2" pipe with cap in centerline Bowers Mill Road (B.T.) and in line with old fence to the North and South - accessories: SW corner garage foundation (house #8520) NE 112.25', Nail W. side P.P. (#79) NNW 69.62', Nail SE side 11" Oak SW 44.70', SE corner house foundation NE 150.70."

B. Description of corner evidence found and/or method applied in restoring or reestablishing corner:

J5 Found 1/2" pipe with cap (PS #25463) in centerline road and two (2) of Tri-County Land Survey witnesses. Accepted pipe as the best evidence of original GLO post.

C. Description of monument for corner and accessories established to perpetuate locating the position of the corner:

J5: Left 1/2" pipe with cap in place and added Monument box
 S6W 32.05', Nail & Tag in twin 13" Oak
 N45W 42.92', Nail & Tag in triple 16" Oak
 N10E 39.73', Nail & Tag in 18" Oak
 N44E 47.14', Nail & Tag in 16" Oak

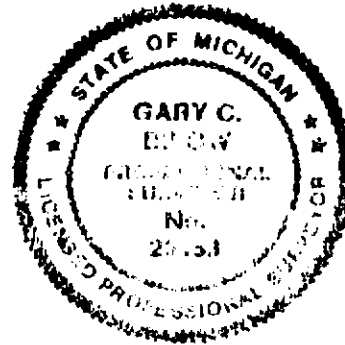

Signed by *Gary C. Bilow*
 Surveyor's Michigan License No. **26453**

Date **8/31/93**