

**LAND CORNER RECORDATION CERTIFICATE**  
**Filing Requirement of Act 74, Mich. P.A. 1970**

For corners in  
Barry

	(County)	Located In:	Corner Code #/
1. Public Land Survey		T <u>3N</u> R <u>10W</u>	<u>J3</u>
		T _____ R _____	_____
		T _____ R _____	_____
		T _____ R _____	_____
2. Property Controlling in Section	S _____	T _____ R _____	_____
	S _____	T _____ R _____	_____
3. Miscellaneous Property in Sec.	S _____	T _____ R _____	_____
	S _____	T _____ R _____	_____

Register of Deeds Stamp & File Number

4. Lot No. \_\_\_\_\_, Recorded Plat \_\_\_\_\_  
 5. Private Claims \_\_\_\_\_

	A	B	C	D	E	F	G	H	I	J	K	L	M
2	6	5	4	3	2	1							
3										●			
4	7	8	9	10	11	12							
5													
6	18	17	16	15	14	13							
7													
8	19	20	21	22	23	24							
9													
10	30	29	28	27	26	25							
11													
12	31	32	33	34	35	36							
13													

I, Gary C. Bilow, in a field survey on April 01, 1993, 19\_\_\_\_, do hereby certify that under requirements of P.A. 74, Michigan P.A. of 1970, the corner points mentioned in lines 1 and 2 above were in conformance with regulations and rules therefore as required in the current manual of survey instructions of the United States Department of the Interior, Bureau of Land Management or by a decree of a Court of Law and/or that the corner points mentioned in lines 3, 4 and 5 above were in conformance with the rules of the Michigan Board of Land Surveyors or by a Decree of a Court of Law; established, re-established, monumented, re-monumented, recovered, found as expressed below:

**NOTE: Not more than 4 corners, all in the same town and range, may be recorded on this certificate.**

**A. Description of original monument and accessories and/or subsequent restoration:**


J3: Post established by U. S. Deputy Surveyor S. Sibley in 1831 - accessories: W. Oak 6 S22W 4 links & Y. Oak 10 N29E 25 links. No other records found.

**B. Description of corner evidence found and/or method applied in restoring or reestablishing corner:**

J3: Reestablished corner in old two-track trail in line with old fence to North. Location is 33 feet South of an old fence running West which is parallel to the section line.

**C. Description of monument for corner and accessories established to perpetuate locating the position of the corner:**

J3: Set 1/2" x 36" rebar encased in 4" diameter concrete cylinder and capped with a cast aluminum Michigan Department of Natural Resources Tablet  
 S50E 32.68', Nail & Tag in 14" triple Oak  
 S10E 9.88', Nail & Tag in 7" W. Pine  
 N55W 19.56', Nail & Tag in 11" Oak  
 N30W 28.35', Nail & Tag in 11" twin Oak  
 Centerline W. track of two track-trail

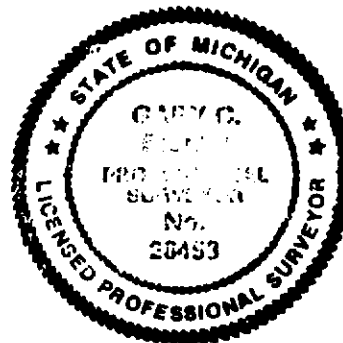

Signed by Gary C. Bilow Date 8/31/93  
 Surveyor's Michigan License No. 26453