

**SURVEY &  
REMONUMENTATION**

APR 08 1996

**Barry County Remonumentation  
LAND CORNER RECORDATION CERTIFICATE  
Filing Requirement of Act 74, Mich. P.A. 1970**

STATE OF MICHIGAN  
COUNTY OF BARRY  
RECEIVED FOR RECORD

Nov 20 9 08 AM '95

For corners in **COMMISSION**

Sandy Schindelmarjer  
REGISTER OF DEEDS

Barry (County)	Located In:	Corner Code #
1. Public Land Survey	T <u>3N</u> R <u>10W</u>	A-11 (NW, 31) Yankee Springs Twp.
	T _____ R _____	_____
	T _____ R _____	_____
	T _____ R _____	_____
2. Property Controlling in Section	S _____ T _____ R _____	_____
	S _____ T _____ R _____	_____
3. Miscellaneous Property in Sec.	S _____ T _____ R _____	_____
	S _____ T _____ R _____	_____

002325

Register of Deeds Stamp & File Number

4. Lot No. \_\_\_\_\_, Recorded Plat \_\_\_\_\_  
5. Private Claims \_\_\_\_\_

	A	B	C	D	E	F	G	H	I	J	K	L	M
2	6	5	4	3	2	1							
3													
4	7	8	9	10	11	12							
5													
6	18	17	16	15	14	13							
7													
8	19	20	21	22	23	24							
9													
10	30	29	28	27	26	25							
11													
12	31	32	33	34	35	36							
13													

I, John C. Bueche, in a field survey on July, 19 95, do hereby certify that under requirements of P.A. 74, Michigan P.A. of 1970, the corner points mentioned in lines 1 and 2 above were in conformance with regulations and rules therefore as required in the current manual of survey instructions of the United States Department of the Interior, Bureau of Land Management or by a decree of a Court of Law and/or that the corner points mentioned in lines 3, 4 and 5 above were in conformance with the rules of the Michigan Board of Land Surveyors or by a Decree of a Court of Law; established, re-established, monumented, re-monumented, recovered, found as expressed below:

**NOTE: Not more than 4 corners, all in the same town and range, may be recorded on this certificate.**

**A. Description of original monument and accessories and/or subsequent restoration:**

A-11 GLO  
Sylvester Sibley, D.S.  
1830  
124 Lks. S of post  
Maple 15 S 13 E 58  
W. Oak 7 N 24 1/2 E 87

Cobb 1909  
Stone 24x12x6 & brk.  
W. Oak 16 E 16'  
W. Oak 7 NE 52 1/2

LCRC #209, May, 1977  
Set T iron on top  
other iron down 1.5'  
C/L 2" steel fence  
post E 32.90'  
Spk. in SW side P&T pole  
N 30 W 55.31'  
Iron in bit. N 82.10'

**B. Description of corner evidence found and/or method applied in restoring or reestablishing corner:**

A-11 Found T iron in Mon. Box


P&T pole N 30 W 55.31'  
Iron in bit. N 82.10'

ACT 345 BARRY COUNTY REMONUMENTATION  
APPROVED BY PEER REVIEW AT A MEETING HELD ON

August 14, 1995 BR  
BRIAN REYNOLDS COUNTY SURVEYOR

**C. Description of monument for corner and accessories established to perpetuate locating the position of the corner:**

A-11 Replaced T iron w/Barry Co. Mon. (3/4" x 24" Pin w/Alum. Cap)  
Conc. Nail & Allegan Co. Remon. Tag in E side PP N 25 W 55.18'  
Conc. Nail & Allegan Co. Remon. Tag in W side Guy Pole N 30 E 53.88'  
Conc. Nail & Allegan Co. Remon. Tag in SE side 22" Oak N 20 E 135.12'  
Face 2" steel fence cor. E 32.80'  
NE cor. Sec. 36, 3-11, North 82.04'  
C/L bit. N-S, West 1'±  
C/L bit. W, North 80'±

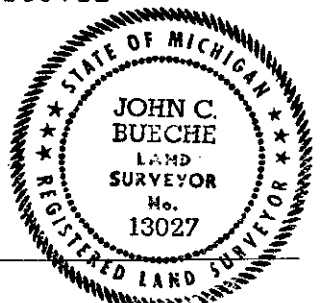

Signed by John C. Bueche  
Surveyor's Michigan License No. 13027

Date Oct 2, 1995