

SURVEY & DOCUMENTATION

BARRY COUNTY REMONUMENTATION
LAND CORNER RECORDATION CERTIFICATE
Filing Requirement of Act 74, Mich. P.A. 1970

DEC 27 2000

SECTION

For corners in

Barry Located in: Yankee Springs Corner Code #
(County)

1. Public Land Survey T 3N R 10W A-12 (W 1/4, 30)

2. Property Controlling
in Section

3. Miscellaneous
Property in Section

S T R

S T R

S T R

S T R

Darla K. Burghdoff - Barry Co. MI LCRCR

Register of Deeds Stamp & File Number



2900

Page: 1 of 1
12/13/2000 07:42A

Seg. #2

4. Lot No. _____ Recorded Plat _____
5. Private Claims _____

I, John C. Bueche, in a field survey on July, 1995 do hereby state that under requirements of P.A. 74, Michigan P.A. of 1970, the corner points mentioned in lines 1 and 2 above were in conformance with regulations and rules therefore as required in the current manual of survey instructions of the United States Department of Interior, Bureau of Land Management or by a decree of a Court of Law and/or that the corner points mentioned in lines 3, 4, and 5 above were in conformance with the rules of the Michigan Board of Land Surveyors or by a Decree of a Court of Law; established, re-established, monumental, recovered, found as expressed below:

NOTE: Not more than 2 corners, all in the same town and range, may be recorded on this certificate.

A B C D E F G H I J K L M

1						
2	6	5	4	3	2	1
3						
4	7	8	9	10	11	12
5						
6	18	17	16	15	14	13
7						
8	19	20	21	22	23	24
9						
10	30	29	28	27	26	25
11						
12	31	32	33	34	35	36
13						

A. Description of original monument and accessories and/or subsequent restoration:

A-12 GLO, Jan., 1826	Old notes	Survey (unrecorded)	
John Mullett, DS	Ash stake	June, 1985	
Br. Oak 7 for corner	Swamp Oak 15" N10	T iron	
	Swamp Oak 13" N67	SE Corner Metal bldg.	S40W 44.00'
		NE Corner Metal bldg.	S70W 27.26'
		NW corner Garg. (conc. Fnd.)	
		Hse. #3525	S35E 182.68'
		Same as other wit.	

B. Description of corner evidence found and/or method applied in restoring or reestablishing corner:


A-1 Found T iron
As per above wit.

And is accepted as a careful and faithful perpetuation of the position of the original corner and has been used as a common corner.

C. Description of monument for corner and accessories established to perpetuate locating the position of the corner:

A-12 Replaced T iron with Allegan Co. (3/4" x 24" pin with cap)

NE corner	Metal bldg.	S70W	27.76'
SE corner	Metal bldg.	S40W	43.98'
SW corner	Metal bldg.	N55E	87.35'
NW corner	base for CP box	S60E	105.34'
At fence corner		S & W	(10'+- long)
C/L bit. N-S,		East	15'+-

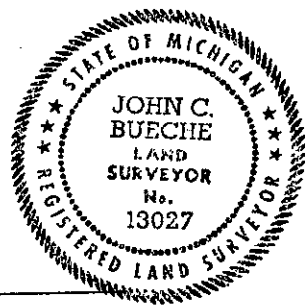

Signed by John C. Bueche Date Nov 30, 2000
Surveyor's Michigan License No. 13027

FORM APPROVED BY MICHIGAN STATE BOARD OF PROFESSIONAL SURVEYORS, JAN., 28, 1971
REVISED MAY 14, 1975
REVISED JAN., 1983
REVISED OCT., 1995

THIS FORM IS BEING
RECORDED TO CORRECT TOWN-RANGE
ERROR ON LCR # 2326 RR

ACT 345 BARRY COUNTY REMONUMENTATION
APPROVED BY PEER REVIEW AT A MEETING HELD ON
August 14, 1995 BR
BRIAN REYNOLDS COUNTY SURVEYOR