

SURVEY & REMONUMENTATION

APR 26 1995

COMMISSION

Barry County Remonumentation
LAND CORNER RECORDATION CERTIFICATE
 Filing Requirement of Act 74, Mich. P.A. 1970

STATE OF MICHIGAN
 COUNTY OF BARRY
 RECEIVED FOR RECORD

Dec 7 3 11 PM '94

Sandy Schondelmar
 REGISTER OF DEEDS

002246

Register of Deeds Stamp & File Number

For corners in

<u>Barry County</u> <small>(County)</small>	Located In: Yankee Springs Twp.	Corner Code # D-8
1. Public Land Survey	T <u>3N</u> R <u>10W</u>	_____
	T _____ R _____	_____
	T _____ R _____	_____
	T _____ R _____	_____
2. Property Controlling in Section	S _____ T _____ R _____	_____
	S _____ T _____ R _____	_____
3. Miscellaneous Property in Sec.	S _____ T _____ R _____	_____
	S _____ T _____ R _____	_____

4. Lot No. _____, Recorded Plat _____
 5. Private Claims _____

	A	B	C	D	E	F	G	H	I	J	K	L	M
2	6	5	4	3	2	1							
3													
4	7	8	9	10	11	12							
5													
6	18	17	16	15	14	13							
7													
8	19	20	21	22	23	24							
9													
10	30	29	28	27	26	25							
11													
12	31	32	33	34	35	36							
13													

I, Robert Jonker, in a field survey on October 4, 1994, do hereby certify that under requirements of P.A. 74, Michigan P.A. of 1970, the corner points mentioned in lines 1 and 2 above were in conformance with regulations and rules therefore as required in the current manual of survey instructions of the United States Department of the Interior, Bureau of Land Management or by a decree of a Court of Law and/or that the corner points mentioned in lines 3, 4 and 5 above were in conformance with the rules of the Michigan Board of Land Surveyors or by a Decree of a Court of Law; established, re-established, monumented, re-monumented, recovered, found as expressed below:

NOTE: Not more than 4 corners, all in the same town and range, may be recorded on this certificate.

1. Description of original monument and accessories and/or subsequent restoration:
 D-8

LCRC #292, 1980, Don Ratekin, Found "T" Iron
 "T" Iron
 Nail on S. side 36" Pine S 85° E 64.13'
 Nail on SW side 26" Oak N 35° E 68.56'
 Nail on S. side 24" Oak N 5° E 57.04'
 Nail on SW side 10" Maple N 40° E 17.1'

2. Description of corner evidence found and/or method applied in restoring or reestablishing corner:
 D-8, Found "T" Iron - by LCRC #292

Nail on W. side 36" Pine S 85° E 64.13'


Also verified by lot corner in the plat of Mastenbrook Sub. in NW¼ of Sec. 20.

Accepted as the best available evidence of the position of the historical corner.

ACT 345 BARRY COUNTY REMONUMENTATION
 APPROVED BY PEER REVIEW AT A MEETING HELD ON
OCT 4TH 1994 ISR
 BRIAN REYNOLDS COUNTY SURVEYOR

3. Description of monument for corner and accessories established to perpetuate locating the position of the corner:
 D-8, Replaced with 36" standard capped Barry County monument.

N & T on N. side 6" Willow Az. 270° 2.09'
 N & T on NE side 16" Oak Az. 145° 23.52'
 N & T on S. side 6" Ash Az. 90° 18.53'
 N & T on W. side 24" Oak Az. 20° 64.67'
 N & T on E. side 16" Oak Az. 355° 91.20'
 C/L of Lynn Drive to North is 50'± West
 C/L of Chief Noonday Road (as traveled) is 33'± North

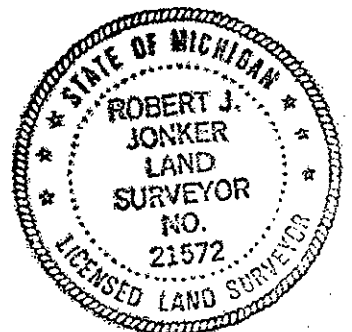

Signed by Robert J. Jonker Date December 07, 1994
 Surveyor's Michigan License No. JONKER LAND SURVEYS, P.C. 21572