

**SURVEY & REMONUMENTATION**

FEB 17 1998

**BARRY COUNTY REMONUMENTATION**

LAND CORNER RECORDATION CERTIFICATE  
Filing Requirement of Act 74, Mich. P.A. 1970

**SECTION**

**002519**

For Corners in <u>BARRY</u> (county)	Located In:	Corner Code #
1. Public Land Survey <b>CENTER OF SECTION 4</b> <b>YANKEE SPRINGS</b> <b>TOWNSHIP</b>	T <u>3N</u> R <u>10W</u>	<u>F-2</u>
	T _____ R _____	_____
	T _____ R _____	_____
	T _____ R _____	_____
2. Property Controlling in Section	S _____ T _____ R _____	_____
	S _____ T _____ R _____	_____
3. Miscellaneous Property in Sec.	S _____ T _____ R _____	_____
	S _____ T _____ R _____	_____
4. Lot No. _____, Recorded Plat _____		
5. Private Claims _____		

STATE OF MICHIGAN  
BARRY COUNTY  
RECORDED

31 JUL 97 9:04 A.M.

SANDY SCHONDELMEYER  
REGISTER OF DEEDS

Register of Deeds Stamp & File Number

I, **Brian Reynolds**, in a field survey on **24 JANUARY, 1997** do hereby certify that under requirements of P.A. 74, Michigan P.A. of 1970, the corner points mentioned in lines 1 and 2 above were in conformance with regulations and rules therefore as required in the current manual of survey instructions of the United States Department of the Interior, Bureau of Land Management or by a decree of a Court of Law and/or that the corner points mentioned in lines 3, 4, and 5 above were in conformance with the rules of the Michigan Board of Land Surveyors or by a Decree of a Court of Law; established, re-established, monumented, re-monumented, recovered, found as expressed below.

	A	B	C	D	E	F	G	H	I	J	K	L	M
2	6	5						3	2	1			
3													
4	7	8	9	10	11	12							
5													
6	18	17	16	15	14	13							
7													
8	19	20	21	22	23	24							
9													
10	30	29	28	27	26	25							
11													
12	31	32	33	34	35	36							
13													

NOTE: Not more than 2 corners, all in the same town and range, may be recorded on this certificate.

A. Description of original monument and accessories and/or subsequent restoration:

- THIS CORNER WAS NOT SET BY THE GENERAL LAND OFFICE.
- COUNTY SURVEYOR RECORDS: A.D. RORK, 2 NOV., 1866 (L.2,P.112) "SET POST & TOOK BEARINGS. STONE & CROCKERY FOR CORNER" W. OAK 14 N79E 80 Do. 14 S44 1/2W 83
- LAND CORNER RECORDATION CERTIFICATE: #269, BY CARROLL D. PIKE, P.S. 24610, 11 MAY, 1979, "T" IRON" P.K. IN 22" HICKORY N60°E 52.19' P.K. IN 6" EVERGREEN S65°E 57.55' P.K. IN 42" OAK S45°W 87.20' P.K. IN 12" OAK N55°W 67.83'
- ACT 132 SURVEY: BY CARROLL D. PIKE, P.S. #24610, 11 MAY, 1979 (L.1,P.514-515) RECITE SAME WITNESSES AS IN L.C.R.C. #269 (ITEM #3 ABOVE)
- COUNTY ROAD COMMISSION: 1988 SHAW LAKE ROAD FIELD BOOK, NO NAME, "FOUND IRON, REPLACED IRON 9-12-88" 40" OAK S40°W 86.9' CORNER POST N45°E 50.9' 6" OAK S35°E 78.1'
- LAND CORNER RECORDATION CERTIFICATE: #421, BY BRIAN REYNOLDS, P.S. #31602, 24 OCT., 1990, "FOUND 1" SOLID IRON" Fd 42" OAK SW OTHER WITNESSES GONE. "NOTE: ... IT LIES 6.2' SOUTH OF A DIRECT LINE FROM G-2 TO THE IRON AT E-2...F-3 WAS NOT CHECKED" CORNER FENCE POST N45°E 51.12' C/L TELEPHONE RISER N45°W 57.47' 8" OAK S45°E 78.22' ON CENTERLINE OF GRAVEL ROADS NORTH, SOUTH, EAST AND WEST


B. Description of corner evidence found and/or method applied in restoring or reestablishing corner:

FOUND 1/2" IRON ON CENTERLINE OF ROADS NORTH-SOUTH-EAST-WEST. FOUND ONE WITNESS BY PIKE, OAK S45°W. FOUND WITNESSES BY REYNOLDS (OAK S45°E GONE). EAST-WEST (SHAW LAKE ROAD) IS NOW PAVED. HISTORY OF "T" IRON IS UNKNOWN (ITEM #3 ABOVE), BUT PROBABLY WAS SET BY "WILLIAMS & WORKS" OR "MEDEMA, VANKOOTEN" PRIOR TO 1970, POSSIBLY AS PERPETUATION OF STONE BY RORK. ACCEPTED FOUND IRON AS BEST EVIDENCE OF CORNER POSITION. REPLACED FOUND IRON WITH STANDARD BARRY COUNTY REMONUMENTATION MONUMENT.

C. Description of monument for corner and accessories established to perpetuate locating the position of the corner:

SET STANDARD BARRY COUNTY REMONUMENTATION MONUMENT (3/4" X 36" IRON) WITH ALUMINUM CAP.  
SET 20d NAIL W/REMON TAG OVER OVERGROWN NAIL IN THE NORTHWEST SIDE OF A 48" OAK S50°W 86.88'  
SET 20d NAIL W/REMON TAG IN THE NORTH WEST SIDE OF A 3" OAK S31°W 77.29'  
SET 20d NAIL W/REMON TAG IN THE SOUTHWEST SIDE OF A WOODEN D.N.R. SIGN POST S40°E 71.10'  
SET 20d NAIL W/REMON TAG IN THE WEST SIDE OF A 28" OAK N10°E 140.82'  
SET 20d NAIL W/REMON TAG IN THE EAST SIDE OF A 4" OAK N12°W 142.51'  
FOUND NAIL IN THE SOUTHEAST SIDE OF A WOODEN FENCE CORNER POST N37°E 56.15'  
CORNER LIES 1' SOUTH OF PAINTED CENTERLINE ROUGHLY ON NORTH-SOUTH CENTERLINE OF GRAVEL ROAD

ACT 345 BARRY COUNTY REMONUMENTATION  
APPROVED BY PEER REVIEW AT A MEETING HELD ON  
NOVEMBER 18, 1996  
BRIAN REYNOLDS COUNTY SURVEYOR

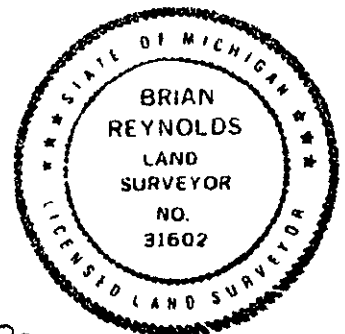

Signed by [Signature]  
Surveyor's Michigan License No 31602

Date JULY 30, 1997  
FORM APPROVED BY MICHIGAN STATE BOARD OF LAND SURVEYORS. JAN. 28, 1971  
REVISED MAY 14, 1975 REVISED JANUARY, 1983 REVISED OCTOBER 1995