

1993

COMMISSION

Barry County Remonumentation LAND CORNER RECORDATION CERTIFICATE Filing Requirement of Act 74, Mich. P.A. 1970

STATE OF MICHIGAN COUNTY OF BARRY RECEIVED FOR RECORD

MAY 14 11 08 AM '93

Sandy Schondelmayer

REGISTER OF DEEDS

002017

Register of Deeds Stamp & File Number

For corners in

Barry

(County)

Located in:

Corner Code #

- 1. Public Land Survey Located in: 3N 10W Corner Code #: G-12 (W 1/4, 34) Yankee Springs Twp.
2. Property Controlling in Section Located in: S T R
3. Miscellaneous Property in Sec. Located in: S T R
4. Lot No. , Recorded Plat
5. Private Claims

I, John C. Bueche in a field survey on January 19 93 do hereby certify that under requirements of P.A. 74, Michigan P.A. of 1970, the corner points mentioned in lines 1 and 2 above were in conformance with regulations and rules therefore as required in the current manual of survey instructions of the United States Department of the Interior, Bureau of Land Management or by a decree of a Court of Law and/or that the corner points mentioned in lines 3, 4 and 5 above were in conformance with the rules of the Michigan Board of Land Surveyors or by a Decree of a Court of Law; established, re-established, monumented, re-monumented, recovered, found as expressed below:

NOTE: Not more than 4 corners, all in the same town and range, may be recorded on this certificate.

A. Description of original monument and accessories and/or subsequent restoration:

G-12 LCRC #191, Jan., 1976
4" x 30" conc. mon. with alum. cap
S 80° W 35.32' 20" Box Elder
N 49° E 38.82' 18" Oak
S 42° E 35.98' 16" Oak


B. Description of corner evidence found and/or method applied in restoring or reestablishing corner:

G-12 Found conc. mon. dated 1976
S 80° W 36'± 20" dbl. Box Elder, partly dead
N 49° E 39'± 18" Oak
S 42° E 36'± 16" Oak

C. Description of monument for corner and accessories established to perpetuate locating the position of the corner:

G-12 DNR conc. mon. dated 1976
Blaze & 40d nail in W side triple 10" Maple N 20° W 23.75'
Blaze & 40d nail in S side 6" Elm N 85° W 28.63'
Blaze & 40d nail in SW side 20" Oak S 40° E 36.17'
Blaze & 40d nail in N side 10" Maple S 75° E 27.34'
Blaze & 40d nail in N side 10" Maple N 65° E 24.06'
Blaze & 40d nail in SE side 16" Maple N 30° E 50.00'
Steel fence post on W side mon., C/L E-W road N 420.'±
Meas. by hand

Grid table with columns A-M and rows 2-13. A triangle marker is located at the intersection of column G and row 12.

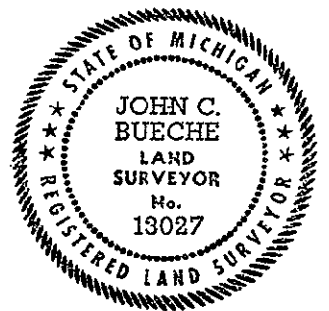

Signed by John C. Bueche

Date 1-27-93

Surveyor's Michigan License No. 13027