

STATE OF MICHIGAN
COUNTY OF BARRY
RECEIVED FOR RECORD

DEC 7 2 04 PM '93

Sandy Schondelmar
REGISTER OF DEEDS

Barry County Remonumentation
LAND CORNER RECORDATION CERTIFICATE
Filing Requirement of Act 74, Mich. P.A. 1970

For corners in

Barry

(County)

Located In:

Corner Code #

1. Public Land Survey

T 3N R 10W

G-13(SW, 34)

T _____ R _____

Yankee Springs Twp.

T _____ R _____

T _____ R _____

2. Property Controlling
in Section

S _____ T _____ R _____

S _____ T _____ R _____

3. Miscellaneous
Property in Sec.

S _____ T _____ R _____

S _____ T _____ R _____

4. Lot No. _____, Recorded Plat _____

5. Private Claims _____

002102

Register of Deeds Stamp & File Number

1. John C. Bueche in a field survey on March, 19 93

do hereby certify that under requirements of P.A. 74, Michigan P.A. of 1970, the corner points mentioned in lines 1 and 2 above were in conformance with regulations and rules therefore as required in the current manual of survey instructions of the United States Department of the Interior, Bureau of Land Management or by a decree of a Court of Law and/or that the corner points mentioned in lines 3, 4 and 5 above were in conformance with the rules of the Michigan Board of Land Surveyors or by a Decree of a Court of Law; established, re-established, monumented, re-monumented, recovered, found as expressed below:

NOTE: Not more than 4 corners, all in the same town and range, may be recorded on this certificate.

	A	B	C	D	E	F	G	H	I	J	K	L	M
2	6	5	4	3	2	1							
3													
4	7	8	9	10	11	12							
5													
6	13	17	16	15	14	13							
7													
8	19	20	21	22	23	24							
9													
10	30	29	28	27	26	25							
11													
12	31	32	33	34	35	36							
13													

A. Description of original monument and accessories and/or subsequent restoration:

G-13 4" x 30" conc. Mon. with alum. cap (Reynolds)

N 47° W 28.55' 19" B. Oak

S 61° W 35.84' 14" W. Oak

N 10° E 14.70' 6" B. Oak

East 16.5' conc. Mon. (NE 4, 2-10)

G-13 LCRC #191

Jan., 1976

Same information as on left

B. Description of corner evidence found and/or method applied in restoring or reestablishing corner:

G-13 Found conc. Mon. with DNR cap @ fence cor. N & E
As per above wit.

APR 05 1994

COMMISSION

C. Description of monument for corner and accessories established to perpetuate locating the position of the corner:

G-13 conc. Mon. with DNR cap

Nail B.C. Remon. Tag in W side 8" Oak N 10° E 14.33'

Nail B.C. Remon. Tag in S side 14" Oak N 85° E 36.32'

Nail B.C. Remon. Tag in S side 10" Ash S 60° E 27.28'


Nail B.C. Remon. Tag in E side 10" Oak S 35° E 22.43'

Nail B.C. Remon. Tag in S side 10" Oak S 5° W 21.25'

Nail B.C. Remon. Tag in N side 8" Oak N 50° W 10.72'

Fence N & E, North 1.0'±

Meas. by hand

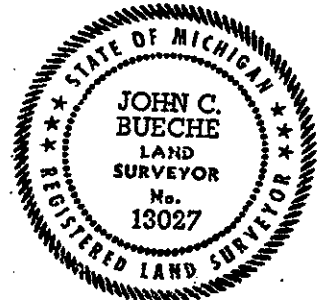

Signed by

John C. Bueche

Date

Oct 29, 1993

Surveyor's Michigan License No.

13027