

**SURVEY & REMONUMENTATION**

1993

**COMMISSION**

**Barry County Remonumentation  
LAND CORNER RECORDATION CERTIFICATE  
Filing Requirement of Act 74, Mich. P.A. 1970**

STATE OF MICHIGAN  
COUNTY OF BARRY  
RECEIVED FOR RECORD

MAY 14 11 08 AM '93

Sandy Schendelmayer  
REGISTER OF DEEDS

For corners in

<u>Barry</u> (County)	Located In:	Corner Code #/
1. Public Land Survey	T <u>3N</u> R <u>10W</u>	I-12 (E 1/4, 34) Yankee Springs Twp.
2. Property Controlling in Section	S ___ T ___ R ___	_____
3. Miscellaneous Property in Sec.	S ___ T ___ R ___	_____
4. Lot No. _____, Recorded Plat _____		
5. Private Claims _____		

**002018**

Register of Deeds Stamp & File Number

I, John C. Bueche, in a field survey on January, 1993, do hereby certify that under requirements of P.A. 74, Michigan P.A. of 1970, the corner points mentioned in lines 1 and 2 above were in conformance with regulations and rules therefore as required in the current manual of survey instructions of the United States Department of the Interior, Bureau of Land Management or by a decree of a Court of Law and/or that the corner points mentioned in lines 3, 4 and 5 above were in conformance with the rules of the Michigan Board of Land Surveyors or by a Decree of a Court of Law; established, re-established, monumented, re-monumented, recovered, found as expressed below:

**NOTE: Not more than 4 corners, all in the same town and range, may be recorded on this certificate.**

	A	B	C	D	E	F	G	H	I	J	K	L	M
2	6	5	4	3	2	1							
3													
4	7	8	9	10	11	12							
5													
6	18	17	16	15	14	13							
7													
8	19	20	21	22	23	24							
9													
10	30	29	28	27	26	25							
11													
12	31	32	33	34	35	36							
13													

A. Description of original monument and accessories and/or subsequent restoration:


I-12 LCRC #191, Jan., 1976  
1 1/4" iron in conc. with 3/4" pipe & cap #12029  
S 43° W 71.81' 12" B. Oak  
S 74° W 6.0' 48" B. Oak, stub 16' high  
S 83° E 25.44' 52" B. Oak  
N 47° E 36.3' SW cor. "David B. Watson" headstone in cemetery

B. Description of corner evidence found and/or method applied in restoring or reestablishing corner:

I-12 Found 1 1/4" iron down 1'±  
S 43° W 72'± 12" B. Oak  
S 83° E 25'± 52" B. Oak  
N 47° E 36.3' SW cor. "David B. Watson" headstone

C. Description of monument for corner and accessories established to perpetuate locating the position of the corner:

I-12 Placed 3/4" x 24" rod with Barry Co. Remon. Cap inside 1 1/4" iron, flush with ground  
SW cor. base (@ ground) headstone "O'Conner" N 05° W 48.05'  
SW cor. base headstone "Courtney" N 70° E 80.62'  
SW cor. base headstone "David B. Watson" N 47° E 36.3'  
Blaze & 40d nail in E side 16" Walnut S 00° W 48.90'  
Blaze & 40d nail in W side 18" Oak S 50° W 71.64'  
C/L E-W gravel road South 20'±  
C/L drive to cemetery East 15'±  
Meas. by hand

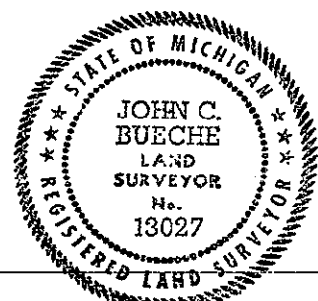

Signed by John C. Bueche Date 1-27-93  
Surveyor's Michigan License No. 13027