SURVEY & REMONUMENTATION

OCT 2 5 1993

COMMISSION

STATE OF MICHIGAN
COUNTY OF BARRY
RECEIVED FOR RECORD

SEP 7 3 33 PM '93

Sandy Schondelmayer
REGISTER OF DEEDS

002083

Register of Deeds Stamp & File Number

BARRY COUNTY REMONUMENTATION

LAND CORNER RECORDATION CERTIFICATE

Filing Requirement of Act 74, Mich. P.A. 1970

For corners in Barry (County)

Located In: YANKEE SPRINGS TWP.

Corner Code ##

1. Public Land Survey — T 3N R 10W — J3
2. Property Controlling — S ___ T ___ R ___
   in Section — S ___ T ___ R ___
3. Miscellaneous — S ___ T ___ R ___
   Property in Sec. — S ___ T ___ R ___

4. Lot No. _____, Recorded Plat _____
5. Private Claims _____

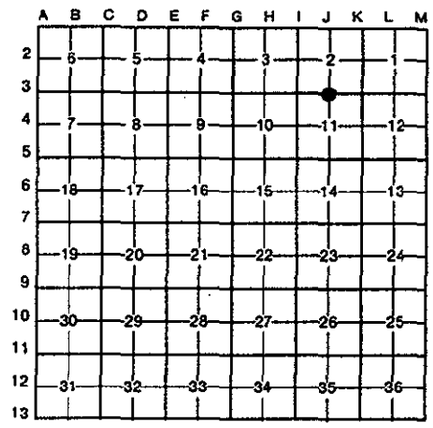

I, Gary C. Bilow, in a field survey on April 01, 1993, 19 _____, do hereby certify that under requirements of P.A. 74, Michigan P.A. of 1970, the corner points mentioned in lines 1 and 2 above were in conformance with regulations and rules therefore as required in the current manual of survey instructions of the United States Department of the Interior, Bureau of Land Management or by a decree of a Court of Law and/or that the corner points mentioned in lines 3, 4 and 5 above were in conformance with the rules of the Michigan Board of Land Surveyors or by a Decree of a Court of Law; established, re-established, monumented, re-monumented, recovered, found as expressed below:

NOTE: Not more than 4 corners, all in the same town and range, may be recorded on this certificate.

A. Description of original monument and accessories and/or subsequent restoration:

J3: Post established by U. S. Deputy Surveyor S. Sibley in 1831 - accessories: W. Oak 6 S22W 4 links & Y. Oak 10 N29E 25 links. No other records found.

B. Description of corner evidence found and/or method applied in restoring or reestablishing corner:

J3: Reestablished corner in old two-track trail in line with old fence to North. Location is 33 feet South of an old fence running West which is parallel to the section line.

C. Description of monument for corner and accessories established to perpetuate locating the position of the corner:

J3: Set 1/2" x 36" rebar encased in 4" diameter concrete cylinder and capped with a cast aluminum Michigan Department of Natural Resources Tablet
S50E 32.68', Nail & Tag in 14" triple Oak
S10E 9.88', Nail & Tag in 7" W. Pine
N55W 19.56', Nail & Tag in 11" Oak
N30W 28.35', Nail & Tag in 11" twin Oak
Centerline N. track of two track-trail

STATE OF MICHIGAN
GARY C. BILOW
PROFESSIONAL SURVEYOR
No. 26453
LICENSED PROFESSIONAL SURVEYOR

Signed by Gary C. Bilow Date 8/31/93

Surveyor's Michigan License No. 26453

FORM APPROVED BY MICHIGAN STATE BOARD OF LAND SURVEYORS, JAN. 28, 1971
REVISED MAY 14, 1975
REVISED JAN., 1983

10/26/93