SURVEY & REMONUMENTATION

OCT 2 5 1993

COMMISSION

STATE OF MICHIGAN
COUNTY OF BARRY
RECEIVED FOR RECORD

SEP 7 3 33 PM '93

Sandy Schondelmayer
REGISTER OF DEEDS

002084

Register of Deeds Stamp & File Number

BARRY COUNTY REMONUMENTATION
LAND CORNER RECORDATION CERTIFICATE
Filing Requirement of Act 74, Mich. P.A. 1970

For corners in Barry (County)

	Located In:	Corner Code ##
	YANKEE SPRINGS TWP.	
1. Public Land Survey	T 3N R 10W	J4
	T ___ R ___	
	T ___ R ___	
	T ___ R ___	
2. Property Controlling	S ___ T ___ R ___	
in Section	S ___ T ___ R ___	
3. Miscellaneous	S ___ T ___ R ___	
Property in Sec.	S ___ T ___ R ___	

4. Lot No. _____, Recorded Plat _____
5. Private Claims _____

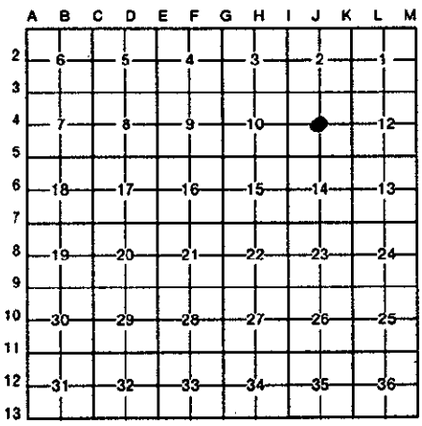

I, Gary C. Bilow, in a field survey on April 01, 1993, 19 ____, do hereby certify that under requirements of P.A. 74, Michigan P.A. of 1970, the corner points mentioned in lines 1 and 2 above were in conformance with regulations and rules therefore as required in the current manual of survey instructions of the United States Department of the Interior, Bureau of Land Management or by a decree of a Court of Law and/or that the corner points mentioned in lines 3, 4 and 5 above were in conformance with the rules of the Michigan Board of Land Surveyors or by a Decree of a Court of Law; established, re-established, monumented, re-monumented, recovered, found as expressed below:

NOTE: Not more than 4 corners, all in the same town and range, may be recorded on this certificate.

A. Description of original monument and accessories and/or subsequent restoration:
J4: Corner not established by U.S. Government survey. No other records found.

B. Description of corner evidence found and/or method applied in restoring or reestablishing corner:
J4: Established corner at the intersection of the North-South and East-West quarter lines.

C. Description of monument for corner and accessories established to perpetuate locating the position of the corner:
J4: Set 1/2" x 36" rebar encased in a 4" diameter concrete cylinder and capped with a cast aluminum Michigan Department of Natural Resources Tablet in 4" x 5' PVC pipe filled with concrete
S63W 53.23', Nail & Tag in 10" Elm
S45W 43.37', Nail & Tag in 8" Elm
N66W 32.45', Nail & Tag in 48" Willow
S70E 44.22', Nail & Tag in 10" Willow clump
East 24', Centerline intermittent stream

STATE OF MICHIGAN
GARY C. BILOW
PROFESSIONAL SURVEYOR
No. 26453
LICENSED PROFESSIONAL SURVEYOR

Signed by Gary C Bilow Date 8/31/93

Surveyor's Michigan License No. 26453

FORM APPROVED BY MICHIGAN STATE BOARD OF LAND SURVEYORS, JAN. 28, 1971
REVISED MAY 14, 1975
REVISED JAN., 1983

10/26/93