SURVEY & REMONUMENTATION

OCT 2 5 1993

COMMISSION

STATE OF MICHIGAN
COUNTY OF BARRY
RECEIVED FOR RECORD

SEP 7 3 33 PM '93

Sandy Schondelmayer
REGISTER OF DEEDS

002088

Register of Deeds Stamp & File Number

BARRY COUNTY REMONUMENTATION
LAND CORNER RECORDATION CERTIFICATE
Filing Requirement of Act 74, Mich. P.A. 1970

For corners in Barry (County)

	Located In:	Corner Code ##
	YANKEE SPRINGS TWP.	
1. Public Land Survey	T 3N R 10W	K3
	T ___ R ___	
	T ___ R ___	
	T ___ R ___	
2. Property Controlling	S ___ T ___ R ___	
in Section	S ___ T ___ R ___	
3. Miscellaneous	S ___ T ___ R ___	
Property in Sec.	S ___ T ___ R ___	

4. Lot No. _____, Recorded Plat _____
5. Private Claims _____

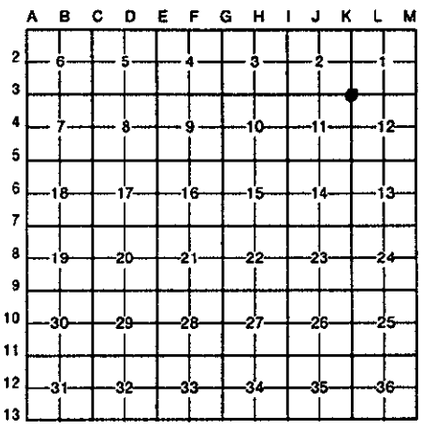

I, Gary C. Bilow, in a field survey on April 01, 1993, 19____, do hereby certify that under requirements of P.A. 74, Michigan P.A. of 1970, the corner points mentioned in lines 1 and 2 above were in conformance with regulations and rules therefore as required in the current manual of survey instructions of the United States Department of the Interior, Bureau of Land Management or by a decree of a Court of Law and/or that the corner points mentioned in lines 3, 4 and 5 above were in conformance with the rules of the Michigan Board of Land Surveyors or by a Decree of a Court of Law; established, re-established, monumented, re-monumented, recovered, found as expressed below:

NOTE: Not more than 4 corners, all in the same town and range, may be recorded on this certificate.

A. Description of original monument and accessories and/or subsequent restoration:
K3: Post established by U.S. Deputy Surveyor S. Sibley in 1831 - accessories: W. Oak 25 N44E 58 links & W. Oak 10 N47W 93 links. No other records found.

B. Description of corner evidence found and/or method applied in restoring or reestablishing corner:
K3: Reestablished corner at intersection of North - South and East - West fencelines.

C. Description of monument for corner and accessories established to perpetuate locating the position of the corner:
K3: Set 1/2" X 36" rebar encased in 4" diameter concrete cylinder and capped with a cast aluminum Michigan Department of Natural Resources Tablet
N5W 27.24', Nail & Tag in 21" Oak
N65E 68.3', Southwest corner block house
S62E 12.66', Nail & Tag in 12" Oak
S8W 14.96', Nail & Tag in twin 22" Oak
North 16', Centerline driveway

STATE OF MICHIGAN
GARY C. BILOW
PROFESSIONAL SURVEYOR
No. 26453
LICENSED PROFESSIONAL SURVEYOR

Signed by Gary C. Bilow Date 8/31/93
Surveyor's Michigan License No. 26453

FORM APPROVED BY MICHIGAN STATE BOARD OF LAND SURVEYORS, JAN. 28, 1971
REVISED MAY 14, 1975
REVISED JAN., 1983

10/26/93