

**SURVEY & REMONUMENTATION**

JUL 24 1997

COMMISSION

**BARRY COUNTY REMONUMENTATION**

STATE OF MICHIGAN  
COUNTY OF BARRY  
RECORDS

MAR 5 9 26 AM '97

**LAND CORNER RECORDATION CERTIFICATE**  
Filing Requirement of Act 74, Mich. P.A. 1970

Sams, [unclear]  
REGISTER OF DEEDS

**002483**

Register of Deeds Stamp & File Number

For corners in **BARRY**  
(County)

Located In:	Corner Code #:
<b>3N 10W</b>	<b>L-5</b>
T _____ R _____	_____
T _____ R _____	_____
T _____ R _____	_____
T _____ R _____	_____
S _____ T _____ R _____	_____
S _____ T _____ R _____	_____
S _____ T _____ R _____	_____
S _____ T _____ R _____	_____

1. Public Land Survey  
**1/4 CORNER COMMON TO SECTIONS 12 & 13 YANKEE SPRINGS TOWNSHIP**

2. Property Controlling in Section  
3. Miscellaneous Property in Sec.

4. Lot No. \_\_\_\_\_, Recorded Plat \_\_\_\_\_  
5. Private Claims \_\_\_\_\_

**BRIAN REYNOLDS**

**22 FEBRUARY**

**95**

I, Brian Reynolds, in a field survey on 22 FEBRUARY, 1995, do hereby certify that under requirements of P.A. 74, Michigan P.A. of 1970, the corner points mentioned in lines 1 and 2 above were in conformance with regulations and rules therefore as required in the current manual of survey instructions of the United States Department of the Interior, Bureau of Land Management or by a decree of a Court of Law and/or that the corner points mentioned in lines 3, 4 and 5 above were in conformance with the rules of the Michigan Board of Land Surveyors or by a Decree of a Court of Law; established, re-established, monumented, re-monumented, recovered, found as expressed below:

**NOTE: Not more than 4 corners, all in the same town and range, may be recorded on this certificate.**

	A	B	C	D	E	F	G	H	I	J	K	L	M
2	6	5	4	3	2	1							
3													
4	7	8	9	10	11	12							
5													
6	18	17	16	15	14	13							
7													
8	19	20	21	22	23	24							
9													
10	30	29	28	27	26	25							
11													
12	31	32	33	34	35	36							
13													

A. Description of original monument and accessories and/or subsequent restoration:

1. GENERAL LAND OFFICE: CORNER ESTABLISHED BY DEPUTY SURVEYOR SYLVESTER SIBLEY, c. 1830  
A. B. OAK 8 N56E 17 Do. 8 S26W 38
2. COUNTY SURVEYOR RECORDS: LEE S. COBB, 1895, "FOUND OLD STAKE & BRICK SET NEW STAKE" L.2, P.204  
APPLE 6 S6E 101 1/2 Do. 8 S54E 104

**\*\*\* NO OTHER HISTORICAL DATA, PUBLIC OR PRIVATE, COULD BE FOUND FOR THIS CORNER \*\*\***


B. Description of corner evidence found and/or method applied in restoring or reestablishing corner:

**FOUND AN IRON PIPE AT APPARENT NORTH RIGHT-OF-WAY LINE OF BOWEN'S MILL ROAD IN LINE WITH OLD OCCUPATION LINE NORTH. MEASURED 33 FEET SOUTH FROM PIPE, EXCAVATED IN GRAVEL ROADWAY. FOUND TWO COMPLETE BRICKS STANDING UPRIGHT ABOUT ONE FOOT BELOW ROAD SURFACE, 32.92 FEET SOUTH OF FOUND PIPE. AFTER MEASURING TO OTHER NEARBY CORNERS, ACCEPTED FOUND BRICKS AS PERPETUATION OF CORNER POSITION BY COBB, AND UNKNOWN SURVEYOR PRIOR TO COBB. REPLACED FOUND BRICKS WITH STANDARD BARRY COUNTY REMONUMENTATION MONUMENT AND CAP.**

ACT 345 BARRY COUNTY REMONUMENTATION  
APPROVED BY PEER REVIEW AT A MEETING HELD ON

9-9-96  
BRIAN REYNOLDS

BR  
COUNTY SURVEYOR

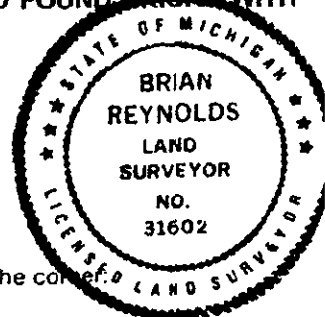

C. Description of monument for corner and accessories established to perpetuate locating the position of the corner:

- SET STANDARD BARRY COUNTY REMONUMENTATION MONUMENT (3/4" X 36" SOLID IRON WITH ALUMINUM CAP)
- SET 20d NAIL W/REMON TAG IN THE EAST SIDE OF A 12" OAK S21°E 104.13'
- SET 20d NAIL W/REMON TAG IN THE WEST SIDE OF AN 18" OAK N07°E 35.81'
- SET 20d NAIL W/REMON TAG IN THE SW SIDE OF THE SOUTH 28" TRUNK OF TWIN OAK N36°W 43.53'
- SET 20d NAIL W/REMON TAG IN THE NORTH SIDE OF A 36" OAK S73°W 66.81'
- SET PK NAIL W/REMON TAG IN THE SE SIDE OF A UTILITY POLE S52°W 102.01'
- 1" PIPE NORTH 32.92' 3'+/- NORTH OF C/L OF GRAVEL ROAD TRACES OF FENCE TO NORTH

Signed by [Signature]

Date FEB 18, 1997

Surveyor's Michigan License No. 31602