

AUG 22 1995

LAND CORNER RECORDATION CERTIFICATE Filing Requirement of Act 74, Mich. P.A. 1970

JAN 25 8 34 AM '95

Sandy Schondelmarper REGISTER OF DEEDS

For corners in COMMISSION BARRY (County)

Table with columns: Located In: (T, R), Corner Code # (M-3)

002265

Register of Deeds Stamp & File Number

- 1. Public Land Survey CORNER COMMON TO SECTIONS 1 & 12 YANKEE SPRINGS TOWNSHIP ON RANGE LINE
2. Property Controlling in Section
3. Miscellaneous Property in Sec.

- 4. Lot No. , Recorded Plat
5. Private Claims

I, BRIAN REYNOLDS, in a field survey on 22 OCTOBER 1994, do hereby certify that under requirements of P.A. 74, Michigan P.A. of 1970, the corner points mentioned in lines 1 and 2 above were in conformance with regulations and rules therefore as required in the current manual of survey instructions of the United States Department of the Interior, Bureau of Land Management or by a decree of a Court of Law and/or that the corner points mentioned in lines 3, 4 and 5 above were in conformance with the rules of the Michigan Board of Land Surveyors or by a Decree of a Court of Law, established, re-established, monumented, re-monumented, recovered, found as expressed below.

Grid table with columns A-M and rows 2-13

NOTE: Not more than 4 corners, all in the same town and range, may be recorded on this certificate.

A. Description of original monument and accessories and/or subsequent restoration:


- 1 GENERAL LAND OFFICE: L. LYON, D.S., 1826 (R10W, P.108) BURR OAK 11 S29W 63 Do. 11 N50 1/2W 43
2 MICHIGAN DEPARTMENT OF TRANSPORTATION: 2587.75' R. OF TAN AT STA. 428+12.51 DRIVE SHAFT SURROUNDED BY BRICK N44°E 55.88' 8" WALNUT N31°E 42.57' 10" WALNUT S56°15'E 72.10' 18" NORWAY S43°15'E 71.38' 16" NORWAY
3 ALSO: SHOWN ON 1963 HIGHWAY PLANS, PAGE 10 (NO WITNESSES)
4 NO OTHER RECORDED HISTORICAL INFORMATION AVAILABLE FOR THIS CORNER

B. Description of corner evidence found and/or method applied in restoring or reestablishing corner:

FOUND AXLE SHAFT SURROUNDED BY BRICK APPROXIMATELY 6" BELOW GRADE. ACCEPTED AXLE SHAFT AS PERPETUATION OF CORNER POSITION. REPLACED AXLE SHAFT WITH STANDARD BARRY COUNTY REMONUMENTATION MONUMENT.

ACT 345 BARRY COUNTY REMONUMENTATION APPROVED BY PEER REVIEW AT A MEETING HELD ON

1 NOV. 1994 BRIAN REYNOLDS COUNTY SURVEYOR

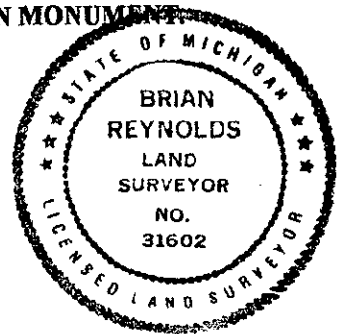

C. Description of monument for corner and accessories established to perpetuate locating the position of the corner:

- SET STANDARD BARRY COUNTY REMONUMENTATION MONUMENT (3/4" X 3/8" W/ALUMINUM CAP)
SET 40d NAIL W/PLASTIC TAG IN THE SOUTH SIDE OF AN 18" PINE N90°E 46.92'
SET 40d NAIL W/PLASTIC TAG IN THE WEST SIDE OF A 28" WALNUT S13°E 139.94'
SET 40d NAIL W/PLASTIC TAG IN THE WEST SIDE OF A UTILITY POLE S19°W 102.5'
SET 40d NAIL W/PLASTIC TAG IN THE SOUTHEAST SIDE OF A 6" OAK S52°W 81.54'
2' EAST OF APPROXIMATE CENTERLINE OF PEETS ROAD
54.35' SOUTH OF THE NORTHWEST CORNER OF SECTION 7, T3N, R9W

Signed by [Signature]

Date JANUARY 24, 1995

Surveyor's Michigan License No. 31602