

**SURVEY & REMONUMENTATION**

**BARRY COUNTY REMONUMENTATION**

FEB 03 1999

LAND CORNER RECORDATION CERTIFICATE  
Filing Requirement of Act 74, Mich. P.A. 1970

SECTION  
For Corners in BARRY  
(county)  
Located In: \_\_\_\_\_ Corner Code # \_\_\_\_\_



**2693**  
Page: 1 of 1  
11/25/1998 12:13P

Sandy Schondelmayer - Barry Co. LCROR

1. Public Land Survey  
**WEST 1/4 CORNER**  
**SECTION 19**  
**WOODLAND TOWNSHIP**  
**ON RANGE LINE**
2. Property Controlling in Section S \_\_\_ T \_\_\_ R \_\_\_  
S \_\_\_ T \_\_\_ R \_\_\_
3. Miscellaneous S \_\_\_ T \_\_\_ R \_\_\_
4. Lot No \_\_\_\_\_ Recorded Plat \_\_\_\_\_
5. Private Claims \_\_\_\_\_

T 4N R 7W A-8  
T \_\_\_ R \_\_\_  
T \_\_\_ R \_\_\_  
T \_\_\_ R \_\_\_

Register of Deeds Stamp & File Number

	A	B	C	D	E	F	G	H	I	J	K	L	M
1													
2	6	5	4	3	2	1							
3													
4	7	8	9	10	11	12							
5													
6	18	17	16	15	14	13							
7													
8	19	20	21	22	23	24							
9													
10	30	29	28	27	26	25							
11													
12	31	32	33	34	35	36							
13													

I, Brian Reynolds, in a field survey on 22 NOV., 1998 do hereby certify that under requirements of P.A. 74, Michigan P.A. of 1970, the corner points mentioned in lines 1 and 2 above were in conformance with regulations and rules therefore as required in the current manual of survey instructions of the United States Department of the Interior, Bureau of Land Management or by a decree of a Court of Law and/or that the corner points mentioned in lines 3, 4, and 5 above were in conformance with the rules of the Michigan Board of Land Surveyors or by a Decree of a Court of Law; established, re-established, monumented, re-monumented, recovered, found as expressed below.

NOTE: Not more than 2 corners, all in the same town and range, may be recorded on this certificate.

A. Description of original monument and accessories and/or subsequent restoration:


- THIS CORNER WAS NOT SET BY THE GENERAL LAND OFFICE.
- COUNTY SURVEYOR RECORDS: LEE S. COBB, OCT. 1894 (WOODLAND FIELD BOOK, PAGE 79) "SET STONE & BRICK" NO WITNESSES GIVEN
- PRIVATE NOTES OF NEDERVELD ASSOCIATES WITNESS SHEET FOR M-8, T4N, R8W, CARLTON TWP., "SET NA CAP 19' +/- WEST OF C/L IN LINE WITH TREE ROW TO THE WEST. SET D.H. NAIL WEST SIDE OF 26" COTTONWOOD AZ 173° 376.97" SET D.H. NAIL WEST BASE OF 26" ELM AZ 16° 775.72 SET D.H. NAIL NORTH BASE OF 20" ELM AZ 270° 86.65" SET D.H. NAIL NORTH BASE OF 12" MAPLE AZ 86° 273.12"

B. Description of corner evidence found and/or method applied in restoring or reestablishing corner:  
FOUND IRON AND WITNESSES AS DESCRIBED IN ITEM #3 ABOVE. EXCAVATED WITH BACKHOE IN GRAVEL ROAD AT APPARENT LOCATION OF CLOSING 1/4 CORNER (A-8), FOUND STONE AND BRICK AS DESCRIBED BY COBB. EXPANDED EXCAVATION 9 FEET SOUTH (MEAN OF GOVERNMENT JOGS IS 8.91'), FOUND A SINGLE POINTED STONE 10.28 FEET SOUTH OF COBB'S CLOSING 1/4 CORNER, APPROXIMATELY 11"X5"X4", STANDING UPRIGHT WITH SMALLER STONES AROUND IT IN CLAY GRADE, BUT NO BRICK, CROCKERY OR OTHER DISTINGUISHING MATERIALS. FOUND STONE WAS IN GRAVEL ROAD, 15.55 FEET EAST OF CORNER POSITION BY NEDERVELD ASSOCIATES. CONFIRMED LOCATION OF RANGE LINE BY RECOVERING 1/8 CORNER STONE AND BRICK BY COBB 1/4 MILE SOUTH, AND DOCUMENTED LOCATION OF M-7. EAST-WEST CORNER LOCATION (M-8) BY NEDERVELD IS APPARENTLY BASED ON GROSSLY ERRONEOUS LOCATION OF M-9 AS RECORDED BY GEORGE YOUNG, P.S. #17640, LAND CORNER RECORDATION CERTIFICATE #189. DISREGARDED EAST-WEST POSITION OF M-8 BY NEDERVELD ASSOCIATES. ACCEPTED FOUND STONE & BRICK AS BEST AVAILABLE EVIDENCE OF CORNER POSITION. REPLACED STONE & BRICK WITH STANDARD BARRY COUNTY 1/2"X36" IRON AND ALUMINUM CAP.

C. Description of monument for corner and accessories established to perpetuate locating the position of the corner:  
SET STANDARD BARRY COUNTY REMONUMENTATION MONUMENT (3/4" X 36" IRON) WITH ALUMINUM CAP. FOUND DOUBLE HEADED NAIL IN THE NORTH SIDE OF A 20" ELM S88° 98.89' FOUND 1/2" CAPPED IRON (NEDERVELD) S58°W 18.39' TOP CENTER OF A RAILROAD RAIL FENCE CORNER POST N89°E 33.25' M-8, T4N, R8W, CARLTON TOWNSHIP LIES S00°W 10.28' CORNER LIES 3'+/- WEST OF CENTERLINE NORTH-SOUTH GRAVEL ROAD

ACT 345 BARRY COUNTY REMONUMENTATION  
APPROVED BY PEER REVIEW AT A MEETING HELD ON

12 OCT. 98  
BRIAN REYNOLDS COUNTY SURVEYOR

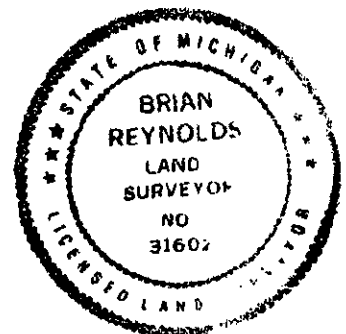

Signed by [Signature]  
Surveyor's Michigan License No 31602

Date Nov 24, 1998  
FORM APPROVED BY MICHIGAN STATE BOARD OF LAND SURVEYORS, JAN. 28, 1971  
REVISED MAY 14, 1975 REVISED JANUARY, 1983 REVISED OCTOBER 1995