

SURVEY & REMONUMENTATION

BARRY COUNTY REMONUMENTATION

FEB 03 1999

LAND CORNER RECORDATION CERTIFICATE  
Filing Requirement of Act 74, Mich. P.A. 1970

For Corners in SECTION Located In: Corner Code #  
BARRY (county)



2697  
Page: 1 of 1  
11/25/1998 12:13P

Sandy Schondelmayer - Barry Co. LORCR

- 1. Public Land Survey  
WEST 1/4 CORNER  
SECTION 31  
WOODLAND TOWNSHIP  
ON RANGE LINE  
T 4N R 7W A-12  
T \_\_\_\_\_ R \_\_\_\_\_  
T \_\_\_\_\_ R \_\_\_\_\_  
T \_\_\_\_\_ R \_\_\_\_\_
- 2. Property Controlling in Section S \_\_\_\_\_ T \_\_\_\_\_ R \_\_\_\_\_  
S \_\_\_\_\_ T \_\_\_\_\_ R \_\_\_\_\_
- 3. Miscellaneous S \_\_\_\_\_ T \_\_\_\_\_ R \_\_\_\_\_
- 4. Lot No \_\_\_\_\_ Recorded Plat \_\_\_\_\_
- 5. Private Claims \_\_\_\_\_

Register of Deeds Stamp & File Number

1	A	B	C	D	E	F	G	H	I	J	K	L	M
2	6	5	4	3	2	1							
3													
4	7	8	9	10	11	12							
5													
6	18	17	16	15	14	13							
7													
8	19	20	21	22	23	24							
9													
10	30	29	28	27	26	25							
11													
12	31	32	33	34	35	36							
13													

I, Brian Reynolds, in a field survey on 23 NOV., 1998 do hereby certify that under requirements of P.A. 74, Michigan P.A. of 1970, the corner points mentioned in lines 1 and 2 above were in conformance with regulations and rules therefore as required in the current manual of survey instructions of the United States Department of the Interior, Bureau of Land Management or by a decree of a Court of Law and/or that the corner points mentioned in lines 3, 4, and 5 above were in conformance with the rules of the Michigan Board of Land Surveyors or by a Decree of a Court of Law; established, re-established, monumented, re-monumented, recovered, found as expressed below.  
NOTE: Not more than 2 corners, all in the same town and range, may be recorded on this certificate.


A. Description of original monument and accessories and/or subsequent restoration:  
1. THIS CORNER WAS NOT SET BY THE GENERAL LAND OFFICE.

\*\*\* NO OTHER HISTORICAL INFORMATION, PUBLIC OR PRIVATE, AVAILABLE FOR THIS CORNER \*\*\*

B. Description of corner evidence found and/or method applied in restoring or reestablishing corner:  
FOUND NO MAGNETIC EVIDENCE OF CORNER POSITION. FOUND STONE AT M-11, CARLTON TWP. AND FOUND A ROTTED WOOD STAKE IN A CIRCLE OF STONES AT A-11. EXCAVATION AT APPARENT CORNER POSITION REVEALED NOTHING.  
SET STANDARD BARRY COUNTY REMONUMENTATION MONUMENT AT THE MID POINT BETWEEN FOUND A-11 AND PREVIOUSLY REMONUMENTED A-13 & ON LINE BETWEEN A-13 AND FOUND STANDARD CORNER M-11, CARLTON TWP.

C. Description of monument for corner and accessories established to perpetuate locating the position of the corner:  
SET STANDARD BARRY COUNTY REMONUMENTATION MONUMENT (3/4" X 36" IRON) WITH ALUMINUM CAP.  
SET 20d NAIL W/PLASTIC TAG IN THE NORTH SIDE OF A 6" WOOD FENCE POST S75°W 28.82'  
SET 20d NAIL W/PLASTIC TAG IN THE SOUTHWEST SIDE OF A 14 " MAPLE S07°W 217.11'  
SET 1/2" IRON W PLASTIC CAP (REYNOLDS TRAV. POINT) S15°E 55.90'  
M-12, T4N, R8W, CARLTON TOWNSHIP, LIES SOUTH 5.94'  
CORNER LIES ROUGHLY ON CENTERLINE OF NORTH-SOUTH GRAVEL ROAD  
6'+/- NORTH OF VAGUE OCCUPATION WEST

ACT 345 BARRY COUNTY REMONUMENTATION  
APPROVED BY PEER REVIEW AT A MEETING HELD ON  
12 OCT. 98 BR  
BRIAN REYNOLDS COUNTY SURVEYOR

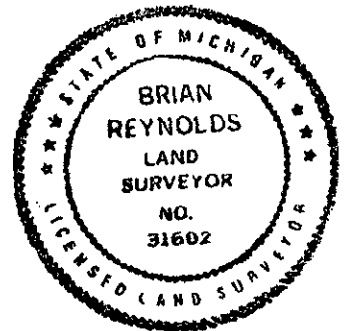

Signed by [Signature]  
Surveyor's Michigan License No 31602

Date Nov 23, 1998  
FORM APPROVED BY MICHIGAN STATE BOARD OF LAND SURVEYORS, JAN. 28, 1971  
REVISED MAY 14, 1975 REVISED JANUARY, 1983 REVISED OCTOBER 1985