

SURVEY & REMONUMENTATION

APR 26 1995

BARRY COUNTY REMONUMENTATION

LAND CORNER RECORDATION CERTIFICATE

FILING REQUIREMENT OF ACT 74, MICH. P.A. 1970

002258

FOR CORNERS OF--	LOCATED IN--	Woodland Township	CORNER CODE NUMBER
1. PUBLIC LAND SURVEY	T. <u>4</u>	N. <u>7</u> S., R. <u>7</u> E. W.	<u>E - 7</u>
2. PROPERTY CONTROLLING IN SECTION	T. _____	N. _____ S., R. _____ E. W.	_____
3. MISCELLANEOUS PROPERTY IN SECTION	T. _____	N. _____ S., R. _____ E. W.	_____
4. LOT NO. _____	RECORDED PLAT _____		_____
5. PRIVATE CLAIMS _____	_____		_____

STATE OF MICHIGAN
 COUNTY OF BARRY
 RECEIVED FOR RECORD
 DEC 13 11 08 AM '94
 Sandy S. Strater
 REGISTER OF DEEDS
 REGISTER OF DEEDS STAMP AND FILING NUMBER

Earl S. Strater

I, Earl S. Strater, do hereby certify that under requirements of P.A. 74, Michigan P.A. of 1970, the corner points mentioned in lines 1 and 2 above were, in a field survey on September 21, 1994, established, re-established, monumented, re-monumented, recovered or restored as expressed below and in conformance with regulations and rules therefore as required in the current manual of survey instructions of the United States Department of the Interior, Bureau of Land Management or by a decree of a court of law. Furthermore, that the corner points mentioned in lines 3, 4 and 5 above were, in a field survey on _____, 19____, found, recovered, restored, established or re-established as expressed below and in conformance with the rules of the Michigan State Board of Registration for Land Surveyors or, by a Decree of a Court of law:

A. Description of original monument and accessories and/or subsequent restoration:

G.L.O. 10" Sugar S11°W 26
22" Beech N19°E 22

County Road Commission Iron fnd.
24" walnut N48°E 46.6'
24" apple S18°E 86.47'
22" walnut N25°E 78.86'

M-43 highway plans 10/14/55 1 3/4" Iron pipe fnd.
3.14' south of construction C/L
26" walnut N48°E 45.84'
4" walnut N55°E 35.58'
power pole N73°W 73.28'

B. Description of corner evidence found and/or method applied in restoring or re-establishing corner:


Found 1' square in monument box, 4.1' south of C/L of M-43

No accessories found.

ACT 345 BARRY COUNTY REMONUMENTATION
 APPROVED BY PEER REVIEW AT A MEETING HELD ON
6 DEC 1994
 BRIAN REYNOLDS
 COUNTY SURVEYOR

C. Description of monument for corner and accessories established to perpetuate locating the position of the corner:

1" square iron in monument box 4.1' south of C/L of M-43
 Nail w/cap south face power pole N71°E 144.20'
 Nail w/cap northwest face power pole S53°W 91.47'
 South face concrete culvert S57°W 79.00'
 North face concrete culvert N52°W 75.43'

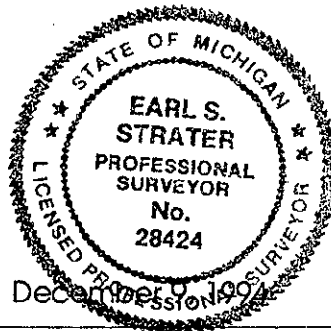

SIGNED BY Earl S. Strater DATE December 10, 1994
 SURVEYOR'S MICHIGAN REGISTRATION NO. 28424 (SEAL)

FOR STATE AND UNITED STATES AGENCIES:

SIGNED BY _____ DATE _____
 CHIEF OF SURVEY PARTY
 APPROVED AND SIGNED BY _____ DATE _____
 MICHIGAN REGISTERED LAND SURVEYOR (SEAL)

SURVEYOR'S MICHIGAN REGISTRATION NO. _____