

MAY 20 1987

COMMISSION

BARRY COUNTY REMONUMENTATION LAND CORNER RECORDATION CERTIFICATE Filing Requirement of Act 74, Mich. P.A. 1970

STATE OF MICHIGAN COUNTY BARRY RECEIVED

DEC 9 2 11 PM '96

Sandy Schindelmaier REGISTER OF DEEDS

- For Corners in BARRY Located In: Corner Code # 1. Public Land Survey T. 4N R. 7W E-13 SW COR TO SEC. 33 WOODLAND TWP. 2. Property Controlling in Section S. T. R. 3. Miscellaneous Property in Sec. S. T. R. 4. Lot No., Recorded Plat. 5. Private Claims.

002456

Register of Deeds Stamp & File Number

I, RAYMOND MOORED, in a field survey on MAY, 1994 do hereby state that under requirements of P.A. 74, Michigan P.A. of 1970, the corner points mentioned in lines 1 and 2 above were in conformance with regulations and rules therefore as required in the current manual of survey instructions of the United States Department of the Interior, Bureau of Land Management or by a decree of a Court of Law and/or that the corner points mentioned in lines 3, 4, and 5 above were in conformance with the rules of the Michigan Board of Land Surveyors or by a Decree of a Court of Law; established, re-established, monumented, recovered, found as expressed below.

Grid table with columns A-M and rows 1-13. A dot is marked at the intersection of column D and row 13.


NOTE: Not more than 2 corners, all in the same town and range, may be recorded on this certificate.

A. Description of original monument and accessories and/or subsequent restoration: GLO S. SIBLEY D.S. 1826 (R7W, P. 123) BEECH 18 N38E 24; SUGAR N49W 40 COUNTY ROAD COMM. STONE ?; STONE 11' EAST; 18" ELM N50W 55'; T.POLE S45W 61.9'; SW COR HDWL NE 51.4

NO OTHER HISTORICAL DATA AVAILABLE

B. Description of corner evidence found and/or method applied in restoring or reestablishing corner: FOUND P.K. NAIL IN CENTERLINE OF ROAD. CHECKED OCCUPATION LINES EAST, WEST AND NORTH. HELD GOV'T JOG DISTANCE WEST TO ESTABLISH E-1 AND THAT LOCATION CHECKED WITH OCCUPATION LINES TO SOUTH. ACCEPTED FOUND P.K. NAIL AS BEST AVAILABLE EVIDENCE OF CORNER LOCATION. SET STANDARD BARRY COUNTY REMONUMENTATION IRON WITH CAP.

C. Description of monument for corner and accessories established to perpetuate locating the position of the corner: SET STANDARD BARRY COUNTY REMONUMENTATION IRON WITH CAP -NAIL & TAG IN N SIDE P POLE S84°W 381.01' -NAIL & TAG IN S SIDE 30" MAPLE N87°W 460.50' -EAST EDGE STOP SIGN POST N32°W 53.46' -NAIL & TAG IN W SIDE 6" ELM N10°E 172.16' -NAIL & TAG IN N SIDE P POLE S81°E 267.96' -NW CORNER SEC. 4, CASTLETON, WEST 27.72'

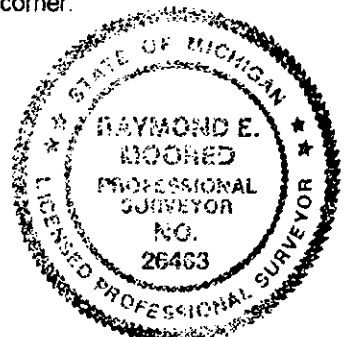

Signed by [Signature]

Date 12/2/96

Surveyor's Michigan License No. 26463

ACT 345 BARRY COUNTY REMONUMENTATION APPROVED BY PEER REVIEW AT A MEETING HELD ON

13 NOV. '95

BRIAN REYNOLDS

[Signature]

COUNTY SURVEYOR