

MAY 20 1997

REMONUMENTATION

BARRY COUNTY REMONUMENTATION
LAND CORNER RECORDATION CERTIFICATE
Filing Requirement of Act 74, Mich. P.A. 1970

STATE OF MICHIGAN
COUNTY OF BARRY
REGISTERED RECORD

DEC 9 2 10 PM '96

Sandy Schendelmayr

REGISTER OF DEEDS

002451

Register of Deeds Stamp & File Number

For corners in

<u>BARRY</u> (County)	Located In:	Corner Code #
1. Public Land Survey	T <u>4</u> R <u>7W</u>	<u>F-13</u>
1/4 COR COMMON TO	T ___ R ___	_____
SEC'S 33	T ___ R ___	_____
WOODLAND TWP.	T ___ R ___	_____
2. Property Controlling	S ___ T ___ R ___	_____
in Section	S ___ T ___ R ___	_____
3. Miscellaneous	S ___ T ___ R ___	_____
Property in Sec.	S ___ T ___ R ___	_____

4. Lot No. _____, Recorded Plat _____
5. Private Claims _____

I, RAYMOND MOORED, in a field survey on Sept, 1995 do hereby state that under requirements of P.A. 74, Michigan P.A. of 1970, the corner points mentioned in lines 1 and 2 above were in conformance with regulations and rules therefore as required in the current manual of survey instructions of the United States Department of the Interior, Bureau of Land Management or by a decree of a Court of Law and/or that the corner points mentioned in lines 3, 4 and 5 above were in conformance with the rules of the Michigan Board of Land Surveyors or by a Decree of a Court of Law; established, re-established, monumented, recovered, found as expressed below:

NOTE: Not more than 2 corners, all in the same town and range, may be recorded on this certificate.

	A	B	C	D	E	F	G	H	I	J	K	L	M
1													
2	6		5		4		3		2		1		
3													
4	7		8		9		10		11		12		
5													
6	18		17		16		15		14		13		
7													
8	19		20		21		22		23		24		
9													
10	30		29		28		27		26		25		
11													
12	31		32		33		34		35		36		
13													

A. Description of original monument and accessories and/or subsequent restoration:

G.L.O. L. LYON D.S. 1826 (R7WP.123) BEECH 6 N. 36 1/2 E. 15 DO. 7 N. 82W. 12. COUNTY SURVEYOR RECORDS FOUND OLD STAKE SET RIFLE B AND STONE & BRICK. COBB MAY 26TH. 1913 (MARGINAL NOTE IN GLO NOTES P.3) (DARK BROWN WOODLAND F.B.) CO ROAD COMM. IRON & STONE 20" ASH S70DEG W. 114.1 IRON POST N. 50.8' T.P. S. 45DEGE. 53.5' (M43 ANGLE 440 F.B, P.2) PLACE MONU BOX 1-26-73.

B. Description of corner evidence found and/or method applied in restoring or reestablishing corner:

FOUND IRON IN MON BOX PER CO. ROAD COMM. INFO IN PART A ABOVE. ASH TREE AND RAILROAD RAIL POST WITNESSES REMAIN. ACCEPTED AS BEST AVAILABLE EVIDENCE OF CORNER LOCATION. SET STANDARD BARRY COUNTY REMONUMENTATION IRON WITH CAP.

ACT 345 BARRY COUNTY REMONUMENTATION
APPROVED BY PEER REVIEW AT A MEETING HELD ON


13 NOV. '95

BRIAN REYNOLDS

COUNTY SURVEYOR

C. Description of monument for corner and accessories established to perpetuate locating the position of the corner:

SET STANDARD BARRY COUNTY REMONUMENTATION IRON WITH CAP.
-NAIL & TAG IN W SIDE POWER POLE S5°W 50.56'
-NAIL & TAG IN N SIDE 28" ASH S70°W 115.32'
-NW COR HSE (SIDING) S50°W 137.88'
-TOP CENTERLINE RR RAIL POST NORTH 50.86'
- NORTH 1/4 COR SEC. 4 (F-1) WEST 28.71'
- CENTERLINE OF ROAD NORTH 3.5'+/-

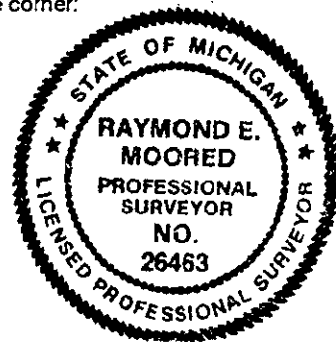

Signed by Raymond Moored
Surveyor's Michigan License No. 26463

Date 11/4/96