

SURVEY & REMONUMENTATION

BARRY COUNTY REMONUMENTATION

FEB 17 1998


LAND CORNER RECORDATION CERTIFICATE
Filing Requirement of Act 74, Mich. P.A. 1970

SECTION

For Corners in BARRY
(county)

Located In:

Corner Code

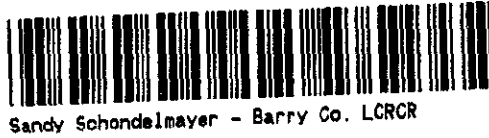

2659

Page: 1 of 1
12/19/1997 07:49A

1. Public Land Survey
CORNER COMMON TO SECTIONS 9, 10, 15, & 16 WOODLAND TOWNSHIP

T 4N R 7W G-5
T _____ R _____
T _____ R _____
T _____ R _____

2. Property Controlling in Section

S _____ T _____ R _____
S _____ T _____ R _____

3. Miscellaneous Property in Sec.

S _____ T _____ R _____
S _____ T _____ R _____

4. Lot No. _____, Recorded Plat _____
5. Private Claims _____

Register of Deeds Stamp & File Number

I, **Brian Reynolds**, in a field survey on **3 APRIL, 1997** do hereby certify that under requirements of P.A. 74, Michigan P.A. of 1970, the corner points mentioned in lines 1 and 2 above were in conformance with regulations and rules therefore as required in the current manual of survey instructions of the United States Department of the Interior, Bureau of Land Management or by a decree of a Court of Law and/or that the corner points mentioned in lines 3, 4, and 5 above were in conformance with the rules of the Michigan Board of Land Surveyors or by a Decree of a Court of Law; established, re-established, monumented, re-monumented, recovered, found as expressed below.

	A	B	C	D	E	F	G	H	I	J	K	L	M
2	6	5	4	3	2	1							
3													
4	7	8	9	10	11	12							
5													
6	18	17	16	15	14	13							
7													
8	19	20	21	22	23	24							
9													
10	30	29	28	27	26	25							
11													
12	31	32	33	34	35	36							
13													

NOTE: Not more than 2 corners, all in the same town and range, may be recorded on this certificate.

A. Description of original monument and accessories and/or subsequent restoration:

1. GENERAL LAND OFFICE: SYLVESTER SIBLEY, D.S., 1830 (R7W, P.143) SUGAR 18 S34W 20 BEECH 6 N68E 7
2. COUNTY SURVEYOR RECORDS: A.C. WILLSON, 13 AUGUST, 1879 (L.1,P.284) "FOUND BY STONE WITH BRICK & GLASS" NO WITNESSES GIVEN, DISTANCE BETWEEN G-5 & G-4 NOTED AS 40.09ch (2645.94')

NO OTHER RECORDED HISTORICAL INFORMATION AVAILABLE FOR THIS CORNER

B. Description of corner evidence found and/or method applied in restoring or reestablishing corner:


FOUND BOAT SPIKE AT INTERSECTION OF NORTH-SOUTH-EAST-WEST CENTERLINES, 3" BELOW BITUMINOUS ROAD GRADE. EXCAVATION AT FOUND BOAT SPIKE REVEALED NO FURTHER EVIDENCE OF CORNER MONUMENTATION. MEASUREMENT BETWEEN G-5 & EAST-WEST OCCUPATION AT G-4 IS COMPARABLE TO SURVEY BY WILLSON (ITEM #2 OF PART "A") 2652 +/- BELIEVE STONE AS REFERRED TO BY WILLSON (ITEM #2 OF PART "A") TO HAVE BEEN REMOVED DURING ROAD CONSTRUCTION. ACCEPTED BOAT SPIKE AS BEST AVAILABLE EVIDENCE OF CORNER POSITION.

REPLACED BOAT SPIKE WITH STANDARD BARRY COUNTY REMONUMENTATION MONUMENT. INSTALLED MONUMENT BOX.

C. Description of monument for corner and accessories established to perpetuate locating the position of the corner:

- SET STANDARD BARRY COUNTY REMONUMENTATION MONUMENT (3/4" X 36" IRON) WITH ALUMINUM CAP AND INSTALLED MONUMENT BOX.
- SET 20d NAIL WIREMON TAG IN THE NORTHWEST SIDE OF A UTILITY POLE S58°W 58.10'
- TOP CENTER OF A STEEL BOLLARD POST SET IN CONCRETE S59°W 46.74'
- FOUND NAIL WWASHER IN THE NORTHEAST SIDE OF A UTILITY POLE S81°E 52.43'
- FOUND NAIL WWASHER IN THE SOUTHEAST SIDE OF A UTILITY POLE N49°E 56.00'
- SET 1/2" IRON WITH PLASTIC CAP "REYNOLDS TRAVERSE POINT" N21°E 72.92'
- SET 1/2" IRON WITH PLASTIC CAP "REYNOLDS TRAVERSE POINT" N38°W 45.94'
- ROUGHLY ON CENTERLINE OF EAST-WEST GRAVEL ROAD ON CENTERLINE OF NORTH-SOUTH BITUMINOUS ROAD

ACT 345 BARRY COUNTY REMONUMENTATION
APPROVED BY PEER REVIEW AT A MEETING HELD ON
14 April 1997
BRIAN REYNOLDS COUNTY SURVEYOR

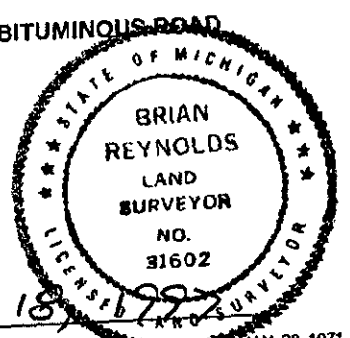

Signed by [Signature]
Surveyor's Michigan License No 31602

Date DECEMBER 18, 1997
FORM APPROVED BY MICHIGAN STATE BOARD OF LAND SURVEYORS: JAN. 28, 1971
REVISED MAY 14, 1975 REVISED JANUARY, 1983 REVISED OCTOBER 1995