

SURVEY & REMONUMENTATION

MAY 20 1997

COMMISSION

For corners in

BARRY

(County)

Located In:

Corner Code #

- 1. Public Land Survey SEC. COR. COMMON TO SEC'S. 33, 34 WOODLAND TWP.
- 2. Property Controlling in Section
- 3. Miscellaneous Property in Sec.

	T	4N	R	7W	G-13
	T		R		
	T		R		
	T		R		
S	T		R		
S	T		R		
S	T		R		
S	T		R		

- 4. Lot No. _____, Recorded Plat _____
- 5. Private Claims _____

I, RAYMOND MOORED, in a field survey on OCT, 1995 do hereby state that under requirements of P.A. 74, Michigan P.A. of 1970, the corner points mentioned in lines 1 and 2 above were in conformance with regulations and rules therefore as required in the current manual of survey instructions of the United States Department of the Interior, Bureau of Land Management or by a decree of a Court of Law and/or that the corner points mentioned in lines 3, 4 and 5 above were in conformance with the rules of the Michigan Board of Land Surveyors or by a Decree of a Court of Law; established, re-established, monumented, recovered, found as expressed below:

NOTE: Not more than 2 corners, all in the same town and range, may be recorded on this certificate.

A. Description of original monument and accessories and/or subsequent restoration:
 G.L.O.L. LYON D.S. 1826 (R7W, P. 123) SUGAR 26 N. 73 WEST 78 L. LYON D.S. 1826 (R7W, PAGE 123) BEECH 7 N34E22 SUGAR 26 N.73 W78 COUNTY SURVEYOR RECORDS A.C.; WILLSON DEC. 1859 (L2, P.33) ESTABLISHED BY CHAINING FROM (F-13) 5 1/4 OF 33 KN TOWN LINE & TOOK BEARINGS SUG 20 N24 1/2 W. 1.25 BEECH 10N 57 1/2W. 1.47 LEE COBB BOOK 9, P.138 DEC. 16, 1892 SET STONE 18X12X8 & BRICK & (DARK BROWN WODLAND F.B, PAGE 67) SUGAR 6 N. 45 1/2 E 56 LKS NOT BLAZED DID NOT LOCATE IRON PIPE & BRICK AXLE SHAFT DRIVEN TO 4" TO 6" ABOVE GROUND N.30 E 57, 1'S24'E24.9'30" MAPLE N45E 36.3' FOUND IRON PIPE (SAME WIT.) (COATS GROVE RD#440, P.1 NO DATE) 12" WALNUT N45W40.7' T. POLE 520E 23.2'

B. Description of corner evidence found and/or method applied in restoring or reestablishing corner:


FOUND P.K. NAIL IN CENTERLINE ROAD. NO ORIGINAL WITNESSES FROM PART A ABOVE REMAIN. CORNER POSITION FIT OCCUPATION LINES TO EAST AND TO WEST ACCEPTED FOUND P.K. AS BEST AVAILABLE EVIDENCE OF CORNER LOCATION.

ACT 345 BARRY COUNTY REMONUMENTATION APPROVED BY PEER REVIEW AT A MEETING HELD ON

13 Nov. 95 BR
 BRIAN REYNOLDS COUNTY SURVEYOR

C. Description of monument for corner and accessories established to perpetuate locating the position of the corner:

- SET STANDARD BARRY COUNTY REMONUMENTATION IRON WITH CAP.
- 20D TAG N.W. SIDE 16" MAPLE N 30" E 63.38'
- 20D TAG N.W. SIDE 20" MAPLE N20"E 121.85'
- 20D TAG N.E. SIDE P POLE N45W. 108.14'
- TOP CENTERLINE TCB S 50"W. 67.28'
- TOP CENTERLINE TCB S 30E. 39.71'
- NE CORNER SEC. 4 W. 29.70'
- IN CENTRLINE RD.

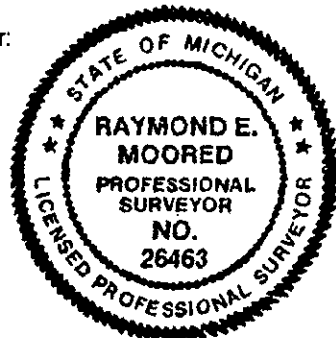

Signed by Raymond Moored
 Surveyor's Michigan License No. 26463

Date 10/7/96

STATE OF MICHIGAN
 COUNTY OF BARRY
 RECEIVED RECORD

DEC 9 2 10 PM '96

Sandy Schendelmayer
 REGISTER OF DEEDS

002449

Register of Deeds Stamp & File Number

1	A	B	C	D	E	F	G	H	I	J	K	L	M
2		6		5		4		3		2		1	
3													
4		7		8		9		10		11		12	
5													
6		18		17		16		15		14		13	
7													
8		19		20		21		22		23		24	
9													
10		30		29		28		27		26		25	
11													
12		31		32		33		34		35		36	
13													