

SURVEY & REMONUMENTATION

FEB 17 1998

BARRY COUNTY REMONUMENTATION

SECTION

LAND CORNER RECORDATION CERTIFICATE  
Filing Requirement of Act 74, Mich. P.A. 1970

2660

Page: 1 of 1  
12/19/1997 07:49A

For Corners in  
BARRY  
(county)

Located in:

Corner Cod



Sandy Schondelmayer - Barry Co. LCRGR

1. Public Land Survey  
1/4 CORNER COMMON TO  
SECTIONS 10 & 15  
WOODLAND TOWNSHIP

T 4N R 7W H-5  
T \_\_\_\_\_ R \_\_\_\_\_  
T \_\_\_\_\_ R \_\_\_\_\_  
T \_\_\_\_\_ R \_\_\_\_\_

2. Property Controlling  
in Section

S \_\_\_\_\_ T \_\_\_\_\_ R \_\_\_\_\_  
S \_\_\_\_\_ T \_\_\_\_\_ R \_\_\_\_\_

3. Miscellaneous  
Property in Sec.

S \_\_\_\_\_ T \_\_\_\_\_ R \_\_\_\_\_  
S \_\_\_\_\_ T \_\_\_\_\_ R \_\_\_\_\_

4. Lot No \_\_\_\_\_, Recorded Plat \_\_\_\_\_  
5. Private Claims \_\_\_\_\_

I, Brian Reynolds, in a field survey on 3 APRIL, 1997 do hereby certify that under requirements of P.A. 74, Michigan P.A. of 1970, the corner points mentioned in lines 1 and 2 above were in conformance with regulations and rules therefore as required in the current manual of survey instructions of the United States Department of the Interior, Bureau of Land Management or by a decree of a Court of Law and/or that the corner points mentioned in lines 3, 4, and 5 above were in conformance with the rules of the Michigan Board of Land Surveyors or by a Decree of a Court of Law; established, re-established, monumented, re-monumented, recovered, found as expressed below.

NOTE: Not more than 2 corners, all in the same town and range, may be recorded on this certificate.

A. Description of original monument and accessories and/or subsequent restoration:

1. GENERAL LAND OFFICE: SYLVESTER SIBLEY, D.S., 1830 (R7W, P.144) WEST CORRECTED 40.08 A BEECH 8 CORNER

NO OTHER INFORMATION, PUBLIC OR PRIVATE, AVAILABLE FOR THIS CORNER


A	B	C	D	E	F	G	H	I	J	K	L	M
2	6	5	4	3	2	1						
3												
4	7	8	9	10	11	12						
5												
6	18	17	16	15	14	13						
7												
8	19	20	21	22	23	24						
9												
10	30	29	28	27	26	25						
11												
12	31	32	33	34	35	36						
13												

B. Description of corner evidence found and/or method applied in restoring or reestablishing corner:

FOUND NO MAGNETIC EVIDENCE OF CORNER MONUMENTATION. PARTIAL TRAVERSE OF SECTIONS 10 & 15, TYING IN G-5, INTERSECTION OF CENTERLINES AT I-5, CENTER OCCUPATION OF BOTH SECTIONS, AND VARIOUS 1/8 LINE OCCUPATION THROUGHOUT BOTH SECTIONS. EXCAVATED A 4' BY 4' AREA 18" DEEP AT PROBABLE CORNER LOCATION, ENCOUNTERED OLD CLAY GRADE AT 8", FOUND NO EVIDENCE OF CORNER MONUMENTATION.

ACT 345 BARRY COUNTY REMONUMENTATION  
APPROVED BY PEER REVIEW AT A MEETING HELD ON  
14 April '97  
BRIAN REYNOLDS COUNTY SURVEYOR

C. Description of monument for corner and accessories established to perpetuate locating the position of the corner:  
SET STANDARD BARRY COUNTY REMONUMENTATION MONUMENT (3/4" X 3/8" IRON) WITH ALUMINUM CAP.  
SET 20d NAIL W/REMON TAG IN THE SOUTH SIDE OF A 5" ELM N68°W 67.99'  
SET 20d NAIL W/REMON TAG IN THE EAST SIDE OF AN 8" ELM S15°W 34.29'  
SET 20d NAIL W/REMON TAG IN THE WEST SIDE OF A 4" ELM N05°W 37.85'  
TOP CENTER OF A TELEPHONE RISER N03°W 30.48'  
IN LINE WITH FENCE/TREE LINE SOUTH ON CENTERLINE OF EAST-WEST GRAVEL ROAD

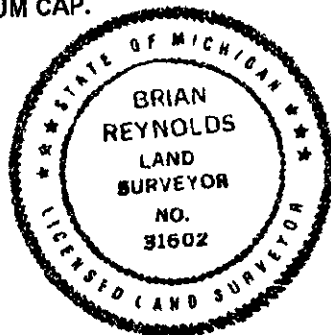

Signed by [Signature]  
Surveyor's Michigan License No 31602

Date DECEMBER 18, 1997  
FORM APPROVED BY MICHIGAN STATE BOARD OF LAND SURVEYORS, JAN. 28, 1971