

**SURVEY & REMONUMENTATION**

**BARRY COUNTY REMONUMENTATION**

APR 26 1995

**LAND CORNER RECORDATION CERTIFICATE**

**COMMISSIONING REQUIREMENT OF ACT 74, MICH. P.A.1970**

Woodland Township

002261

FOR CORNERS OF--	LOCATED IN--	CORNER CODE NUMBER
1. PUBLIC LAND SURVEY	T. 4 N. S., R. 7 E. W.	H-7
2. PROPERTY CONTROLLING IN SECTION	T. N. S., R. E. W.	
3. MISCELLANEOUS PROPERTY IN SECTION	T. N. S., R. E. W.	
4. LOT NO.	RECORDED PLAT	
5. PRIVATE CLAIMS		

STATE OF MICHIGAN  
 COUNTY OF BARRY  
 RECEIVED FOR RECORD  
 DEC 13 11 08 AM '94  
 Sander S. Skonkowski  
 REGISTER OF DEEDS  
 REGISTER OF DEEDS STAMP AND FILING NUMBER

I, Earl S. Strater, do hereby certify that under requirements of P.A. 74, Michigan P.A. of 1970, the corner points mentioned in lines 1 and 2 above were, in a field survey on September 21, 1994, established, re-established, monumented, re-monumented, recovered or restored as expressed below and in conformance with regulations and rules therefore as required in the current manual of survey instructions of the United States Department of the Interior, Bureau of Land Management or by a decree of a court of law. Furthermore, that the corner points mentioned in lines 3, 4 and 5 above were, in a field survey on \_\_\_\_\_, 19\_\_\_\_, found, recovered, restored, established or re-established as expressed below and in conformance with the rules of the Michigan State Board of Registration for Land Surveyors or, by a Decree of a Court of law:

A. Description of original monument and accessories and/or subsequent restoration:

G.L.O. 6" Beech N04°W 14  
 12" Ash N38°E 29

County Road Commission 3/4" Iron bar  
 14" poplar S40°E 29.41'  
 16" maple N57°W 48.30'  
 14" maple N72°W 84.69'

M-43 highway plans 3/4" Iron pin fnd.  
 16" maple N55°W 48.26'  
 15" poplar S40°E 29.34'  
 telephone pole S80°W 115.30'

B. Description of corner evidence found and/or method applied in restoring or re-establishing corner:

Found 1/2" rebar in monument box, 0.70' south of C/L of M-43


No accessories found.

ACT 345 BARRY COUNTY REMONUMENTATION  
 APPROVED BY PEER REVIEW AT A MEETING HELD ON

6 DEC 1994 BR  
 BRIAN REYNOLDS COUNTY SURVEYOR

C. Description of monument for corner and accessories established to perpetuate locating the position of the corner:

1/2" rebar in monument box 0.70' south of C/L of M-43  
 spike in west face power pole N04°E 59.47'  
 spike in west face power pole S09°W 56.83'  
 C/L face of culvert N29°E 34.23'  
 spike in east face 12" cottonwood S03°E 54.82'

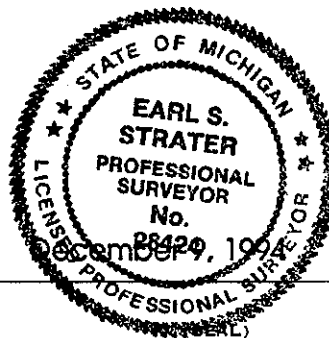

SIGNED BY Earl S. Strater DATE \_\_\_\_\_

SURVEYOR'S MICHIGAN REGISTRATION NO. 28424

FOR STATE AND UNITED STATES AGENCIES:

SIGNED BY \_\_\_\_\_ DATE \_\_\_\_\_

CHIEF OF SURVEY PARTY

APPROVED AND SIGNED BY \_\_\_\_\_ DATE \_\_\_\_\_

MICHIGAN REGISTERED LAND SURVEYOR

(SEAL)

SURVEYOR'S MICHIGAN REGISTRATION NO. \_\_\_\_\_