BARRY CO.
REMONUMENTATION

APR 0 8 1996

COMMISSION

STATE OF MICHIGAN
COUNTY OF BARRY
RECEIVED FOR RECORD

NOV 8 10 48 AM '95

Sandy Schondelmayer
REGISTER OF DEEDS

002313

Register of Deeds Stamp & File Number

BARRY COUNTY REMONUMENTATION
LAND CORNER RECORDATION CERTIFICATE
Filing Requirement of Act 74, Mich. P.A. 1970

For corners in
BARRY
(County)

	Located In:	Corner Code ##
1. Public Land Survey 1/4 COR. COMMON TO SEC'S. 2 & 11 WOODLAND TWP.	T 4N R 7W	J-3
	T R	
	T R	
	T R	
2. Property Controlling	S T R	
in Section	S T R	
3. Miscellaneous	S T R	
Property in Sec.	S T R	

4. Lot No. _____ , Recorded Plat _____
5. Private Claims _____

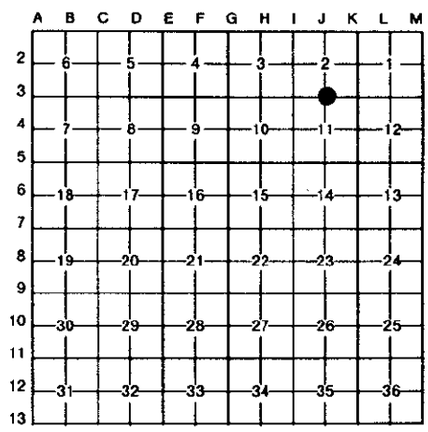

I, RAYMOND MOORED, in a field survey on 24 AUG., 19 94, do hereby certify that under requirements of P.A. 74, Michigan P.A. of 1970, the corner points mentioned in lines 1 and 2 above were in conformance with regulations and rules therefore as required in the current manual of survey instructions of the United States Department of the Interior, Bureau of Land Management or by a decree of a Court of Law and/or that the corner points mentioned in lines 3, 4 and 5 above were in conformance with the rules of the Michigan Board of Land Surveyors or by a Decree of a Court of Law; established, re-established, monumented, re-monumented, recovered, found as expressed below:

NOTE: Not more than 4 corners, all in the same town and range, may be recorded on this certificate.

A. Description of original monument and accessories and/or subsequent restoration:

GENERAL LAND OFFICE S. SIBLEY, D.S. 1830(R7W PG 140) SUGAR 10 N3W 5; SUGAR 10 S32E 9
BOWEN OCT7-9, 1878 (L-1, PG 260) SET STONE FOR CORNER: BEECH 10 N80-1/2W 2.37

NO OTHER HISTORICAL DATA AVAILABLE

B. Description of corner evidence found and/or method applied in restoring or reestablishing corner:

NO CORNER WAS FOUND. RECORDED PLATS OF "LAKEWOOD ACRES" AND "LAKEWOOD ACES NO. 2"(REC IN LIBER 5 ON PAGES 12 & 69) INDICATED THAT THE NORTH AND WEST LINES OF SAID PLATS WERE THE NORTH LINE AND NORTH AND SOUTH 1/4 LINE OF SECTION 11; FROM EXISTING MONUMENTATION IN SAID PLATS, INTERSECTED BOTH PLAT LINES AND ESTABLISHED LOCATION OF J-3. POSITION OF CORNER IS CONSISTENT WITH MDOT STATIONING WEST TO I-3. ACCEPTED POSITION AS BEST AVAILABLE EVIDENCE OF CORNER LOCATION.
SET STANDARD BARRY COUNTY REMONUMENTATION IRON WITH CAP.

ACT 345 BARRY COUNTY REMONUMENTATION
APPROVED BY PEER REVIEW AT A MEETING HELD ON
OCT 9, 1995 BR
BRIAN REYNOLDS COUNTY SURVEYOR

C. Description of monument for corner and accessories established to perpetuate locating the position of the corner:

SET STANDARD BARRY COUNTY REMONUMENTATION IRON WITH CAP.
-NAIL IN WEST SIDE POWER POLE DUE NORTH 59.00'
-NAIL IN EAST SIDE POWER POLE DUE SOUTH 60.80'
-NAIL IN NORTH SIDE POWER POLE S80°E 217.79'
-NAIL IN WEST SIDE 4" WILD CHERRY S3°W 59.19'
-REMON IRON IN MON BOX (I-3) WEST 2650.74'

STATE OF MICHIGAN
RAYMOND E. MOORED
PROFESSIONAL SURVEYOR
NO. 26463
LICENSED PROFESSIONAL SURVEYOR

Signed by Raymond Moored Date 11/1/95
Surveyor's Michigan License No. 26463

FORM APPROVED BY MICHIGAN STATE BOARD OF LAND SURVEYORS, JAN. 28, 1971
REVISED MAY 14, 1975
REVISED JAN., 1983