

OFFICE OF
REMONUMENTATION

MAY 20 1997

COMMISSION

BARRY COUNTY REMONUMENTATION
LAND CORNER RECORDATION CERTIFICATE
Filing Requirement of Act 74, Mich. P.A. 1970

STATE OF MICHIGAN
COUNTY OF BARRY
RECEIVED

DEC 9 2 11 PM '96

Sandy Schindelmayer
REGISTER OF DEEDS

For Corners in BARRY	Located In:	Corner Code #
1. Public Land Survey S1/4 TO SEC. 35 WOODLAND TWP.	T..4N R..7W T..... R..... T..... R..... T..... R.....J-13.....
2. Property Controlling in Section	S.....T..... R..... S.....T..... R.....
3. Miscellaneous Property in Sec.	S..... T..... R..... S..... T..... R.....
4. Lot No....., Recorded Plat.....		
5. Private Claims.....		

002450

Register of Deeds Stamp & File Number

	A	B	C	D	E	F	G	H	I	J	K	L	M
1													
2	6	5	4	3	2	1							
3													
4	7	6	9	10	11	12							
5													
6	18	17	16	15	14	13							
7													
8	19	20	21	22	23	24							
9													
10	30	29	28	27	26	25							
11													
12	31	32	33	34	35	36							
13													

I, RAYMOND MOORED, in a field survey on MAY, 1994 do hereby state that under requirements of P.A. 74, Michigan P.A. of 1970, the corner points mentioned in lines 1 and 2 above were in conformance with regulations and rules therefore as required in the current manual of survey instructions of the United States Department of the Interior, Bureau of Land Management or by a decree of a Court of Law and/or that the corner points mentioned in lines 3, 4, and 5 above were in conformance with the rules of the Michigan Board of Land Surveyors or by a Decree of a Court of Law; established, re-established, monumented, recovered, found as expressed below.

NOTE: Not more than 2 corners, all in the same town and range, may be recorded on this certificate.

A. Description of original monument and accessories and/or subsequent restoration:
GLO L. LYON D.S. 1826 (R7W, P. 122) WEST SOUTH SIDE SECTION 35 40.00 SET POST . BEECH 20 N51E 29; BEECH 8 N35W 25.


NO OTHER HISTORICAL DATA AVAILABLE

B. Description of corner evidence found and/or method applied in restoring or reestablishing corner:
FOUND NO EVIDENCE OF CORNER. SET CORNER ON LINE BETWEEN K-1 AND H-1 ON OCCUPATION LINE TO NORTH ACCEPTED POSITION AS BEST AVAILABLE EVIDENCE OF CORNER LOCATION. SET STANDARD BARRY COUNTY REMONUMENTATION IRON WITH CAP.

C. Description of monument for corner and accessories established to perpetuate locating the position of the corner:
SET STANDARD BARRY COUNTY REMONUMENTATION IRON WITH CAP
-NAIL & TAG IN E SIDE 12" PINE SOUTH 58.78'
-NAIL & TAG IN NORTH SIDE 15" MAPLE S45°W 70.74'
-NORTH 1/4 COR SECTION 2 (J-1) WEST 67.84'
-C/L ROAD NORTH 1.9'
-SE CORNER SEC. 35 (K-13) EAST 2662.82'

Signed by Raymond Moored
Surveyor's Michigan License No. 26463

Date 12/2/96

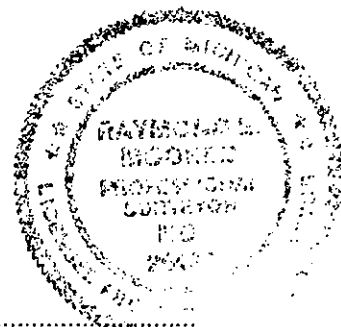

ACT 345 BARRY COUNTY REMONUMENTATION
APPROVED BY PEER REVIEW AT A MEETING HELD ON
13 Nov. '95 BR
BRIAN REYNOLDS COUNTY SURVEYOR