

SURVEY & REMONUMENTATION

BARRY COUNTY REMONUMENTATION

JUL 24 1997

LAND CORNER RECORDATION CERTIFICATE
Filing Requirement of Act 74, Mich. P.A. 1970

COMMISSION

002496

For Corners in BARRY (county) Located In: Corner Code #
1. Public Land Survey T 4N R 7W K-1
CORNER COMMON TO T R
SECTIONS 1 & 2 T R
WOODLAND TOWNSHIP T R
ON TOWNSHIP LINE
2. Property Controlling S T R
in Section S T R
3. Miscellaneous S T R
Property in Sec. S T R
4. Lot No , Recorded Plat
5. Private Claims

STATE OF MICHIGAN
BARRY COUNTY
RECORDED
17 JUN 97 12:19 P.M.
SANDY SCHONDELMAYER
REGISTER OF DEEDS

Register of Deeds Stamp & File Number

Table with 13 columns (A-M) and 13 rows (2-13) containing numbers 1-36 in a grid pattern.

I, Brian Reynolds, in a field survey on 16 MAY, 1997 do hereby certify that under requirements of P.A. 74, Michigan P.A. of 1970, the corner points mentioned in lines 1 and 2 above were in conformance with regulations and rules therefore as required in the current manual of survey instructions of the United States Department of the Interior, Bureau of Land Management or by a decree of a Court of Law and/or that the corner points mentioned in lines 3, 4, and 5 above were in conformance with the rules of the Michigan Board of Land Surveyors or by a Decree of a Court of Law; established, re-established, monumented, re-monumented, recovered, found as expressed below.

NOTE: Not more than 2 corners, all in the same town and range, may be recorded on this certificate.

A. Description of original monument and accessories and/or subsequent restoration:

- 1. GENERAL LAND OFFICE: SYLVESTER SIBLEY, D.S. 1830, (R8W,P.136) "NORTH 81.25 NORTH BOUNDARY 49 lks WEST OF POST" A BEECH 6 S62E 12 A SUGAR 12 S73W 39
2. COUNTY SURVEYOR RECORDS: BOWEN, OCT. 1878 (L.1,P.261) "LIMESTONE FOR CORNER" (NO WITNESSES)
3. ALSO: WALTER HEATH, APRIL 18-19, 1905 (L.3,P.102) "FOUND LIMESTONE" SOUTHWEST CORNER OF HOUSE N46E 1ch 19 1/4lks

\*\*\* NO OTHER RECORDED HISTORICAL INFORMATION AVAILABLE FOR THIS CORNER \*\*\*


B. Description of corner evidence found and/or method applied in restoring or reestablishing corner:

FOUND 1/2" IRON IN GRAVEL ROAD. EXCAVATION REVEALED A 6"x 12"x 14" POINTED LIMESTONE STANDING NEXT TO IRON. FOUND STONE WAS 0.07' SOUTH OF TOWNSHIP LINE. ACCEPTED FOUND LIMESTONE AS CORNER BY BOWEN.

REPLACED FOUND LIMESTONE WITH STANDARD BARRY COUNTY REMONUMENTATION MONUMENT ON TOWNSHIP LINE.

C. Description of monument for corner and accessories established to perpetuate locating the position of the corner:

SET STANDARD BARRY COUNTY REMONUMENTATION MONUMENT (3/4" X 36" IRON) WITH ALUMINUM CAP. FOUND NAIL W/TAG IN THE SOUTHWEST SIDE OF A UTILITY POLE N41°W 47.79' FOUND NAIL W/TAG IN THE NORTHWEST SIDE OF A UTILITY POLE N51°E 64.83' FOUND NAIL W/TAG IN THE SOUTHEAST SIDE OF A UTILITY POLE N64°E 53.37' FOUND NAIL W/TAG IN THE NORTHWEST SIDE OF A UTILITY POLE S25°W 79.56' SOUTHWEST CORNER OF STONE FOUNDATION OF HOUSE N44°E 111.61' K-13, TOWN 5 NORTH, RANGE 7 WEST, IONIA COUNTY, LIES EAST 29.14' CORNER LIES 5' +/- NORTH OF CENTERLINE EAST-WEST GRAVEL ROAD

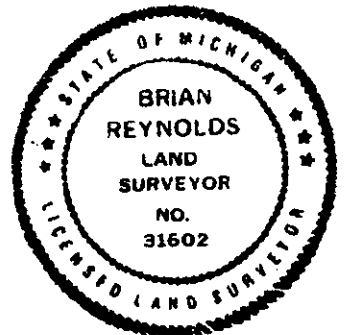

ACT 345 BARRY COUNTY REMONUMENTATION APPROVED BY PEER REVIEW AT A MEETING HELD ON

7-10-95 BR
BRIAN REYNOLDS COUNTY SURVEYOR

Signed by [Signature]
Surveyor's Michigan License No 31602

Date MAY 16, 1997