

FEB 03 1999

BARRY COUNTY REMONUMENTATION

SECTION

LAND CORNER RECORDATION CERTIFICATE
Filing Requirement of Act 74, Mich. P.A. 1970

For Corners in BARRY Located In: Corner Code #
(county)



2698
Page: 1 of 1
11/25/1998 12:13P

1. Public Land Survey T 4N R 7W K-3
CORNER COMMON TO T _____ R _____
SECTIONS 1, 2, 11, & 12 T _____ R _____
WOODLAND TOWNSHIP T _____ R _____

Sandy Schondelmayer - Barry Co. LCRCR

Register of Deeds Stamp & File Number

2. Property Controlling S _____ T _____ R _____
in Section S _____ T _____ R _____

3. Miscellaneous S _____ T _____ R _____
Property in Sec. S _____ T _____ R _____

4. Lot No _____, Recorded Plat _____

5. Private Claims _____

	A	B	C	D	E	F	G	H	I	J	K	L	M
2	6	5	4	3	2	1							
3													
4	7	8	9	10	11	12							
5													
6	18	17	16	15	14	13							
7													
8	19	20	21	22	23	24							
9													
10	30	29	28	27	26	25							
11													
12	31	32	33	34	35	36							
13													

I, **Brian Reynolds**, in a field survey on **10 MAY, 1997** do hereby certify that under requirements of P.A. 74, Michigan P.A. of 1970, the corner points mentioned in lines 1 and 2 above were in conformance with regulations and rules therefore as required in the current manual of survey instructions of the United States Department of the Interior, Bureau of Land Management or by a decree of a Court of Law and/or that the corner points mentioned in lines 3, 4, and 5 above were in conformance with the rules of the Michigan Board of Land Surveyors or by a Decree of a Court of Law; established, re-established, monumented, re-monumented, recovered, found as expressed below.

NOTE: Not more than 2 corners, all in the same town and range, may be recorded on this certificate.

A. Description of original monument and accessories and/or subsequent restoration:

- GENERAL LAND OFFICE: SYLVESTER SIBLEY, D.S. 1830, (R8W,P.135) A SUGAR 8 S66W 14 1/2 AN IRONWOOD 7 N73E 16
- COUNTY SURVEYOR RECORDS: BOWEN, 7-9 OCT., 1878 (L.1,P.260) "STONE FOR CORNER"
- ALSO: WALTER HEATH, APRIL 18-19, 1905 (L.3,P.102) "STONE"
- COUNTY ROAD COMMISSION: 1920 NASHVILLE ROAD FIELD BOOK PAGE 16, P.O.E. STA. 531+61.9 COR. PO. 41.7 SE COR. PO. 39.3 NE
- ALSO: 1955 HIGHWAY PLANS, PAGE 12, "STONE & PIPE" POW. POLE N20W 56.74' 8" ASH N21E 88.22' 15" MAPLE N40E 49.41' NW COR HOUSE S30E 144.60' FC. COR. N42W 38.1' FC. COR. S39E 41.9' FC. COR. S35W 40.55' 10" SPRUCE N53E 41.68' U.S.G.S. BM #6984 N50E 41.00'
- CONSUMERS POWER COMPANY: (NO DATE) "STONE" COR. FENCE POST NE 39.3' COR. FENCE POST SE 41.7'
- RECORDED PLATS OF LAKEWOOD ACRES (L.5,P.12) 12 OCT., 1963, AND LAKEWOOD ACRES No. 2 (L.5,P.69) 15 JAN., 1968 BY Wm. HUME ROGERS P.S. #6197, REFERENCED, NO WITNESSES.
- PRIVATE NOTES OF SURVEY BY BRIAN REYNOLDS, P.S. #31602, SURVEY IN SECTION 1 OF WOODLAND TWP., DATED JULY 27, 1995, FOUND EMPTY MONUMENT BOX, MDOT DISTANCE FROM K-3 TO M-3 5337.77, COMPUTED CENTERLINE BETWEEN K-3 AND M-3 INCLUDING DEFLECTIONS, ACCEPTED CENTER OF MONUMENT BOX CASTING AS BEST AVAILABLE EVIDENCE OF CORNER POSITION FOR PURPOSES OF ESTABLISHING CORNER POSITION FOR L-3. CORNER NOT WITNESSED AND NO MONUMENT INSTALLED.
- LAND CORNER RECORDATION CERTIFICATE: #606, BY ROBERT LIIMAKKA, P.S., #40161, 5 MAR., 1997 "SET MONUMENT BOX & IRON" N30°E 87.04' NAIL IN STUMP S45°W 67.67' CAPPED IRON S45°E 72.42' PHONE RISER DUE SOUTH 50.01' PK IN BIT. ROAD

B. Description of corner evidence found and/or method applied in restoring or reestablishing corner:

CORNER POSITION WAS ESTABLISHED AS DESCRIBED IN ITEM #8 ABOVE. SUBSEQUENT TO PEER GROUP APPROVAL OF THE POSITION DESCRIBED IN ITEM # 8 ABOVE, BUT PRIOR TO INSTALLATION OF REMON MONUMENT, THE IRON DESCRIBED IN ITEM #9 WAS INSTALLED BY ROBERT LIIMAKKA, P.S., #40161 AT THE PEER APPROVED POSITION, AS PART OF MDOT CORNER PRESERVATION CONTRACT. FOUND NAIL IN STUMP AND TELE RISER WITNESSES BY LIIMAKKA, DID NOT FIND CAPPED IRON WITNESS. FOUND PK IN BIT ROAD AT 59.94 FEET SOUTH, AND MAGNETIC INDICATION OF PK BELOW NEW BITUMINOUS AT 50.01 FEET AS REPORTED BY LIIMAKKA. ACCEPTED POSITION MONUMENTED BY LIIMAKKA AS POSITION PREVIOUSLY PEER APPROVED. INSTALLED REMON CAP ON IRON BY LIIMAKKA IN MON BOX.


C. Description of monument for corner and accessories established to perpetuate locating the position of the corner:

- STANDARD BARRY COUNTY REMONUMENTATION MONUMENT (3/4" X 36" IRON) WITH ALUMINUM CAP IN MON. BOX.
- TOP CENTER OF A CONCRETE RIGHT-OF-WAY MARKER N10°E 177.70'
- TOP CENTER OF A CONCRETE FENCE POST N15°E 111.38'
- SET 20d NAIL W/REMON TAG IN THE EAST SIDE OF A UTILITY POLE N17°W 134.53'
- NORTHWEST CORNER HOUSE FOUNDATION S55°E 144.76'
- TOP CENTER OF EAST END OF METAL CULVERT N26°E 59.12'
- 2.25'+/- NORTH OF PAINTED CENTERLINE

ACT 345 BARRY COUNTY REMONUMENTATION
APPROVED BY PEER REVIEW AT A MEETING HELD ON

10 JULY 95
BRIAN REYNOLDS COUNTY SURVEYOR

Signed by _____
Surveyor's Michigan License No 31602

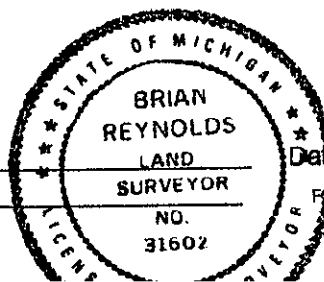

Date Nov 24, 1998
FORM APPROVED BY MICHIGAN STATE BOARD OF LAND SURVEYORS. JAN. 28, 19
REVISED MAY 14, 1975 REVISED JANUARY, 1983 REVISED OCTOBER 1995